

# Water Service Record

Name

Jay Ron

Service No.

Address

32 Middle St

Location


Repair - Renewal New Service

Date	Material	Amount	Total	Date		Amount
2/21/21	1" type K copper					
	1" curb stop					
	open right					
	comb. brass					

TOWN OF LEXINGTON - BOARD OF PUBLIC WORKS  
WATER DIVISION

Date: 2/21/21

SKETCH OF SERVICE HERE

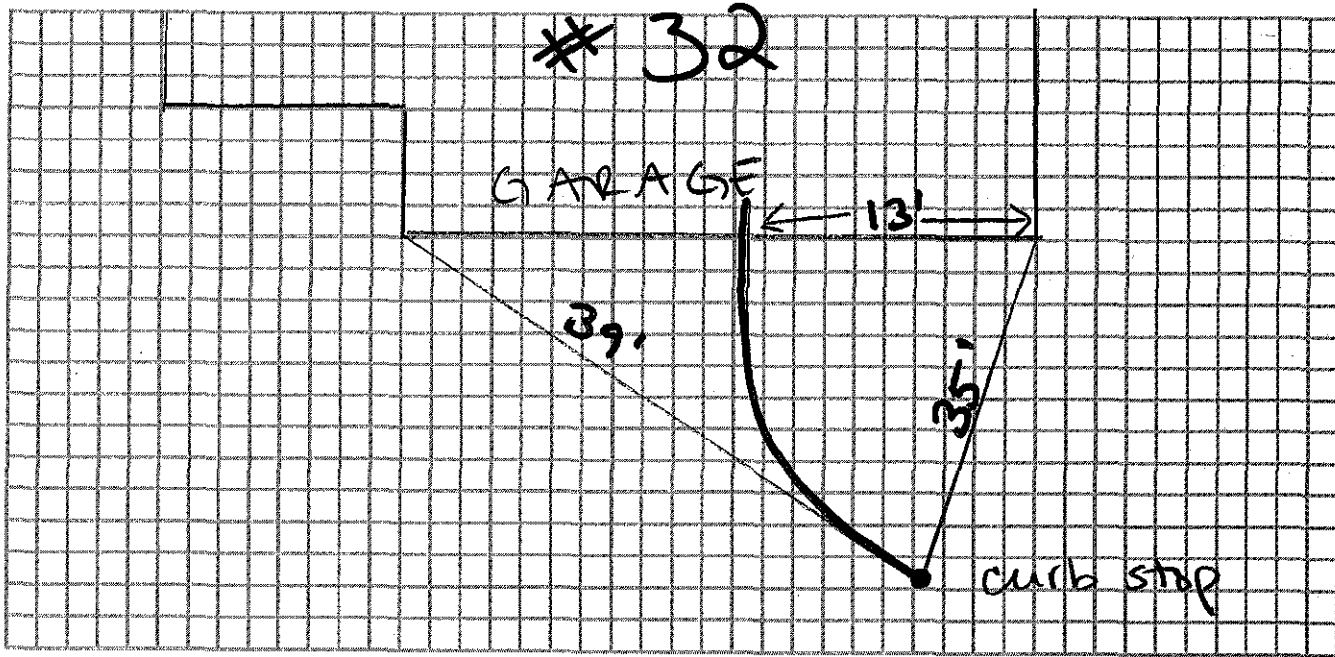

Connection made in: Middle

Street:

Work completed:

Remarks:

depth @ curb stop = 5'