

Name W. L. Smith

Service No. 48 1988

Address Lex. Lumber Co.  
35 Middle St.

#35  
Location Pasquale Panetta, Middle St.

Kind of Pipe

Size

Size of Main

~~Repair - Renewal~~ - New Service

Location

Date	Material	Amount	Total	Date	Amount
P. 11-18-30 for 10.00	7 Hrs. Labor @.55	3 85			
	3 " " @.60	1 80		Oct 8 1930 - Cash	10 -
<u>COST</u>	15% Overhead	<u>85</u>	\$6 50		
<u>CHARGE</u>	As Per Agreement,		\$10 00		

Hadley Press, Inc., Lexington

Labor

W. L. Smith - pay bills @ Leds Lumber Co.

DATE Sept. 24, 1938

Owner is Pasquale Panetta

# TOWN OF LEXINGTON - BOARD OF PUBLIC WORKS WATER DIVISION

(Napoli's Farm)

The undersigned applies for a supply of water at No. Middle St. and hereby agrees to comply with the rules and regulations as now, or at any future time, established by the Board of Selectmen.

Am't. of Estimate \$ 10<sup>00</sup>

Builder/Owner John J. Kardigic


Am't. Paid \$ \_\_\_\_\_

Address 243 Dale St

Builder \_\_\_\_\_

Waltham Mass

Sketch of Service Here

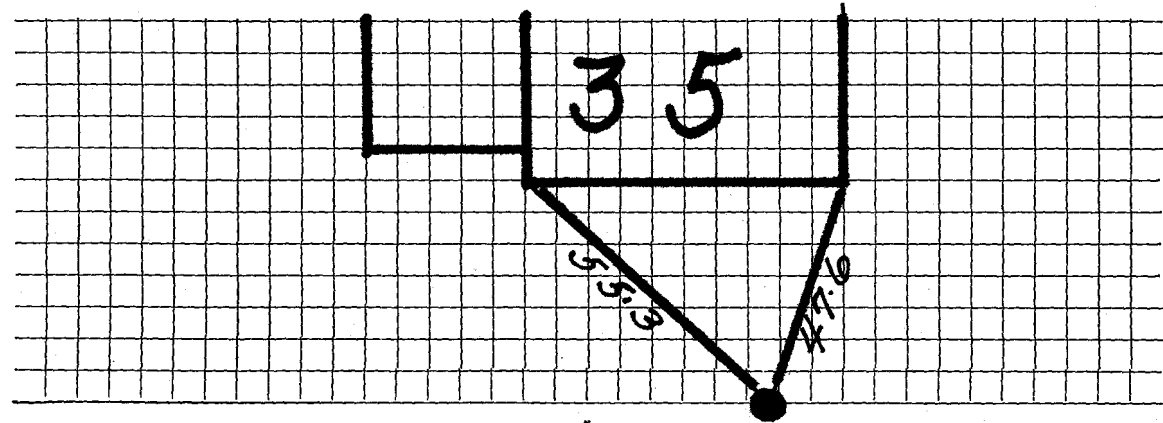

Connection made in \_\_\_\_\_ Street.

Work completed \_\_\_\_\_ 19

Remarks: