




DATE 1/6/94

TOWN OF LEXINGTON — BOARD OF PUBLIC WORKS

**WATER DIVISION**

Sketch of Service Here

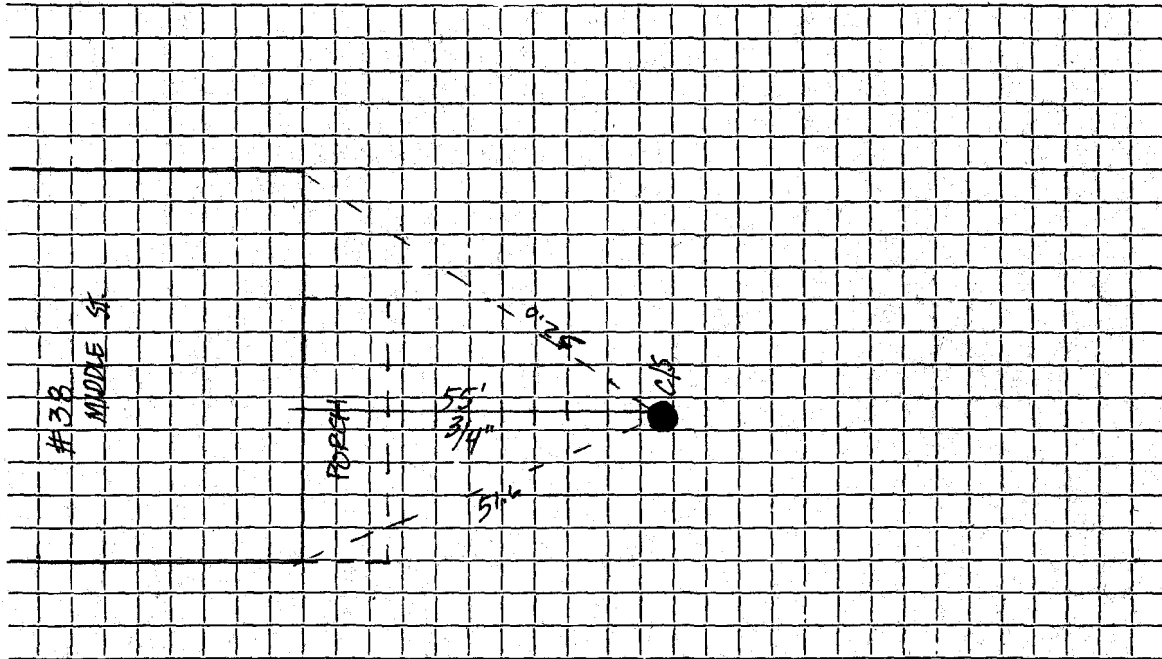

Connection made in ..... Street. Work completed 12/17/93 B. MCKEE .....

Remarks: Original Service ..... ? .....