

WATER SERVICE RECORD

2193

Service No. 63

Name Jo Jen Realty Trust

Address

Location 41 Middle St/

~~Remainder of Record~~ New Service ~~XXXXXX~~ W.O. # 7191

APR 6 1970


Date		Material	Amount	Total	Date		Amount
12/9/69		Labor		14 06	12-3-69	Deposit	100 00
		10% O.H.		1 41	4-6-70	Returned	53 39
	10'	3/4" Copperpipe .79		7 90			44 41
		3/4" Corporation		9 57			
		3/4" Curb stop		8 57			
		Box & Rod		5 10	12/3/75	W.O. #3850. NON-CHARGE (Change over to new main)	
				46 61		5 Ft. 3/4" Copper @1.01	\$5.05
					1	3/4" 3 Part Union	4.69
					1	3/4" Corporation	10.53
8/20/70	37'	3/4" Copper tubing					\$20.27
		---Dave Eagle permit # 1703					

DATE _____

TOWN OF LEXINGTON -- BOARD OF PUBLIC WORKS

WATER DIVISION

Sketch of Service Here

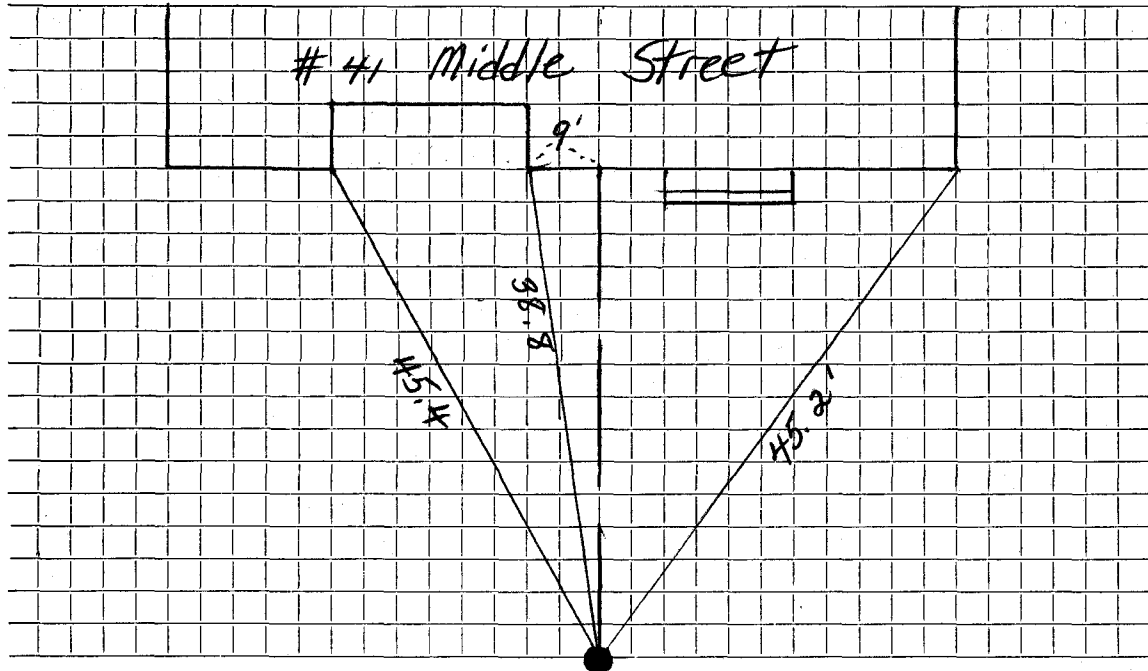

Connection made in Street. Work completed

Remarks:

.....

.....