



*Rig amount*

DATE October 3, 1928

# TOWN OF LEXINGTON - BOARD OF PUBLIC WORKS

## WATER DIVISION

The undersigned applies for a supply of water at No. 165 - ~~Marrett Road~~ <sup>4th Middle Street</sup> St. and hereby agrees to comply with the rules and regulations as now, or at any future time, established by the Board of Selectmen.

Am't. of Estimate \$ \_\_\_\_\_


Owner Harriet Jewels

Am't. Paid \$ 40.00

Address Lawrence Ave Lex

Builder D. M. Kellan  
42 Trapeze Rd., Belmont

Sketch of Service Here

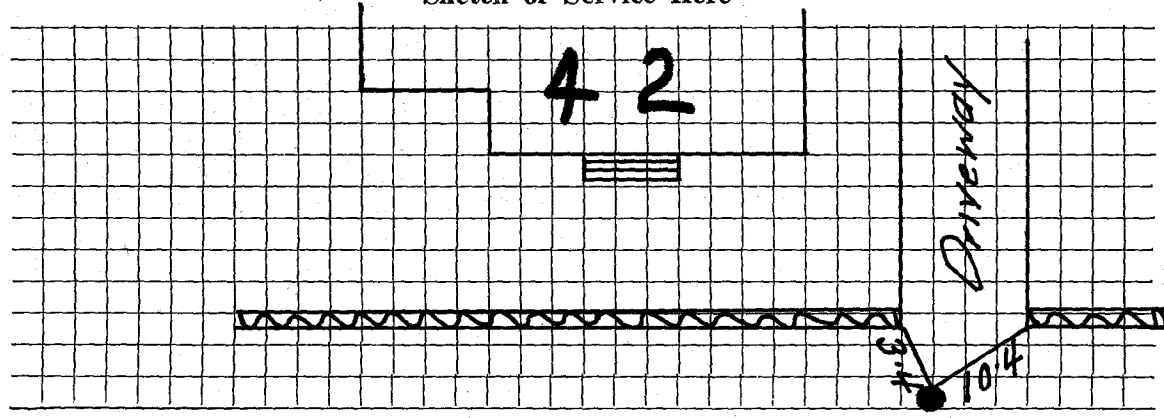

Connection made in \_\_\_\_\_ Street.

Work completed \_\_\_\_\_ 19

Remarks: