

## WATER SERVICE RECORD

Name R.D. Hamilton

Service No. 49

Address 44 Middle Street

Location

~~Repaired~~ New Service W. O. # 9992

FEB 12 1973


Date		Material	Amount	Total	Date	Amount
9/7/72		Labor	22 16		8/15/72	Deposit 125 00
	10%	O.H.	2 22	24 38	2/12/73	Refund 38 24
	31'	3/4" Copper pipe .79		24 49		86 76
		3/4" Corporation		9 57		
		3/4" Curb stop		11 32		
	1	Hr. Truck		3 00		
	1	Hr. Shovel		6 50		
				86 76		
7/1/74	2'	3/4 COPPER				
	1	3/4 Comp Curb				
	1	3/4 Comp UNION				

DATE \_\_\_\_\_

# TOWN OF LEXINGTON — BOARD OF PUBLIC WORKS

## WATER DIVISION

Sketch of Service Here

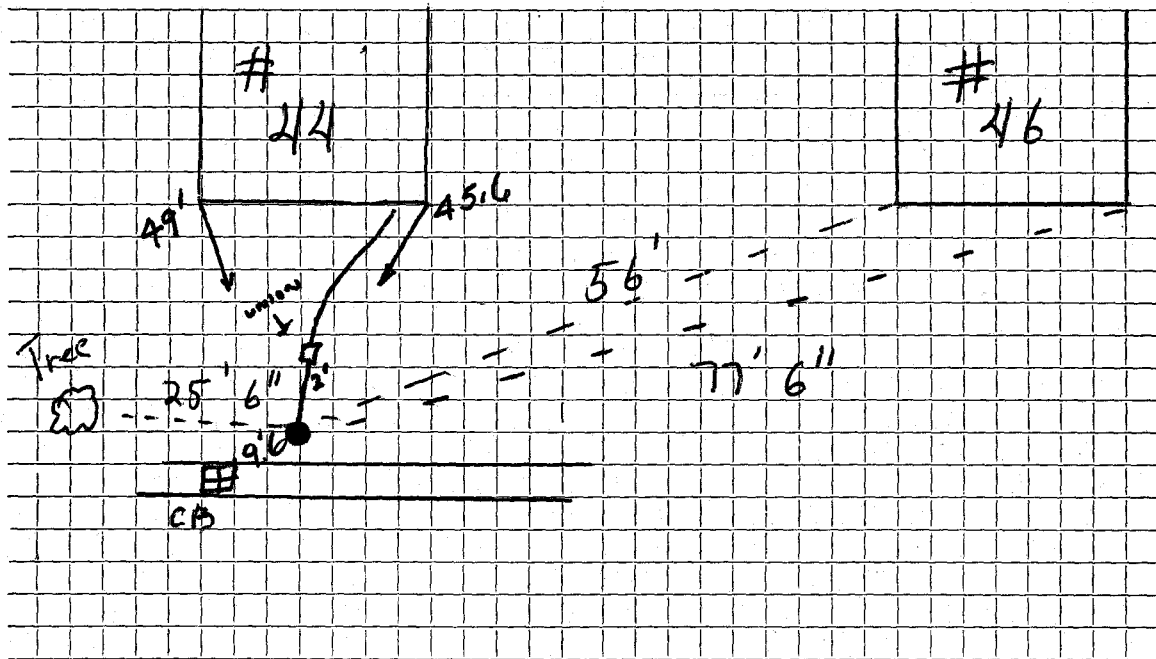

Connection made in ..... Street. Work completed .....

Remarks: .....

.....  
.....