

WATER SERVICE RECORD

#262
#4316
205

Name Lawrence Moulthrop

Service No.

Address 45 Middle St.

Location Lexington

~~REPAIR WORK~~ New Service

Com. 9-14-53


Date	Material	Amount	Total	Date	Amount
8/21/53	Labor	1 90		7-22-53	40 00
	10% overhead	19	2 09	9-14-53	11 39
	60'-3/4" Copper Tubing @.3629	21 77			28 61
	1-3/4" C x 1/2 I.W.H. STOP & WASTE	4 00		8/21/53	Labor
	1 Hr. Trucking		75	20'-3/4" Copper Tubing @.3629	7 26
			28 61	1-3/4" C. Corp-cock	4 33
				1-3/4" C x 3/4" C. Curb-cock	4 67
				1-Box & Rod	3 90
				1-1/2 offset tail piece	50
				1-1/2 straight tail piece	50
				1 Hr. Trucking	75
					23 81
					NON-CHARGE (Change over to new main)
				12/9/75	5 Ft. 3/4" Copper @1.01
					1 3/4" 3 Part Union
					1 3/4" Corporation
					\$20.27

DATE _____

TOWN OF LEXINGTON - BOARD OF PUBLIC WORKS

WATER DIVISION

Sketch of Service Here

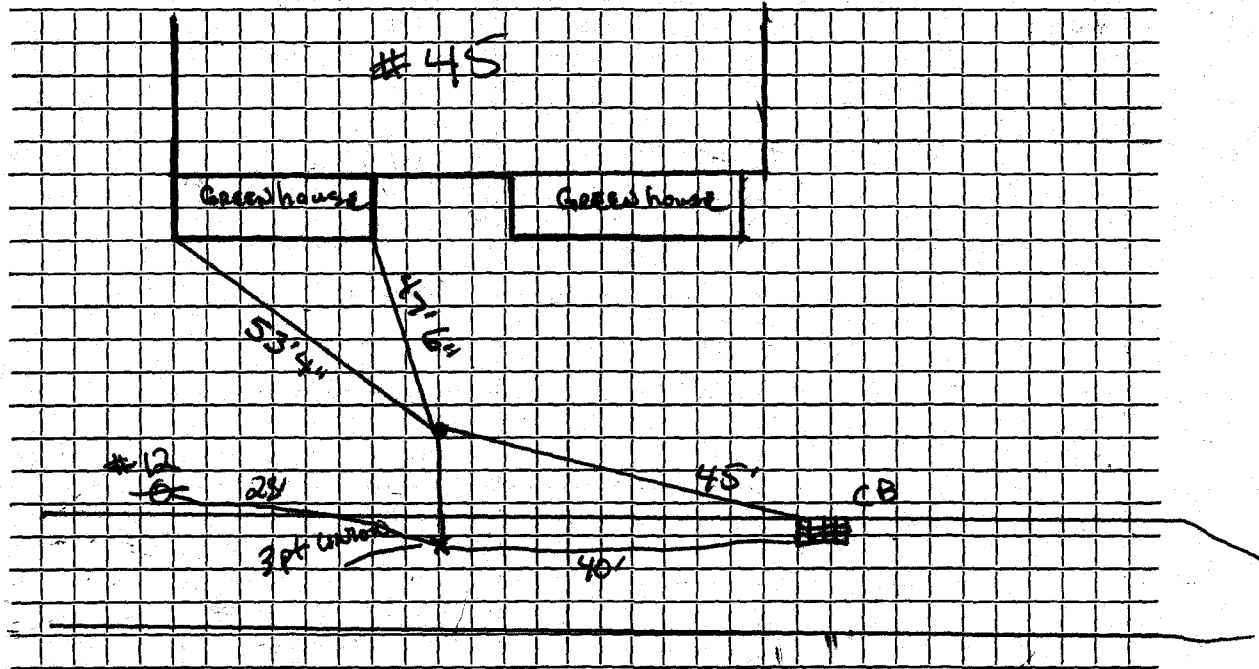

Connection made in Street. Work completed

Remarks:

.....

.....