

Name

Service No. 1992 #3041
#5042

Address 50 middle st.

Location 50 Middle St.

Kind of Pipe

Size

Size of Main

Repair—Renewal—New Service

Location

Date

Material

Amount

Total

Date

Amount

w.o. #3851
NON-CHARGE (OUTSIDE RENEWEL)

December 3, 1975	3/4" Copper	@1.01 (19Ft.)	19.19
1	3/4" Corporation		10.53
1	3/4" Curb Stop		13.70
1	1" x 3/4" Lead Bushing		1.72
1	Style 38 1" Repair Clamp		5.25
			\$50.39

Labor

TOWN OF LEXINGTON—BOARD OF PUBLIC WORKS

WATER DIVISION

The undersigned applies for a supply of water at No. _____ St. and hereby agrees to comply with the rules and regulations as now, or at any future time, established by the Board of Selectmen.

Am't. of Estimate \$ _____


Owner W. Vose

Am't. Paid \$ _____

Address 50 Middle St.

Builder _____

Sketch of Service Here

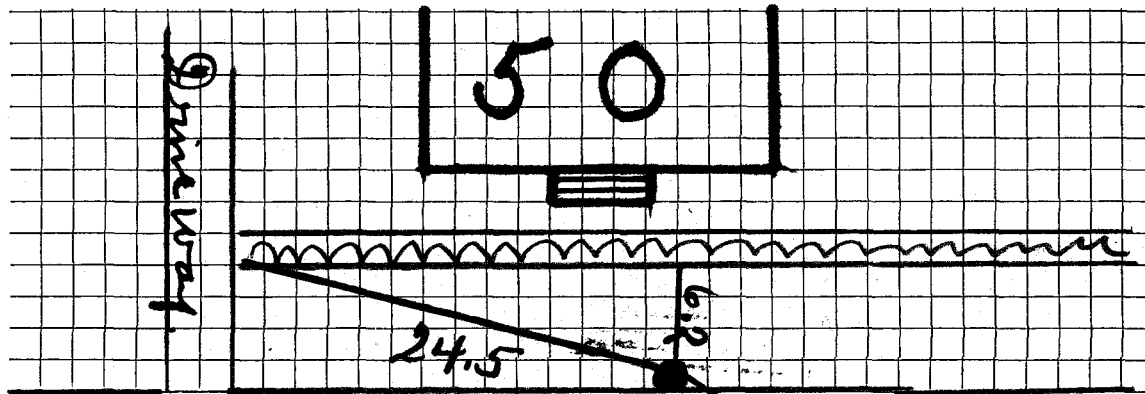

Connection made in Middle Street St Work completed _____ 19

Remarks:

31.8 pipe