

Name Victor Olsen

2025  
Service No. 28 1978

Address 45 Dartmouth Court, Everett, Mass.

to middle St.

Location Lot 147, Middle St. #6

Kind of Pipe

Size

Size of Main

~~Repair-Renewal~~ New Service

Location

Date

Material

Amount

Total

Date

Amount

40' 1" C.L. Pipe @.27 10 80

2 1" L.L. Coup. @.30 60

2 1" L.L. Ells @.35 70

2 1" Br. Sp. Nipp. @.25 50

1 S & W 3 00

Trucking 75

16 35

May 22 1931 - Cash

28 50

PL-16-31  
for  
28.50

Hadley Press, Inc. Lexington

7/8/31 7 Hrs. Labor @.55 3 85

3 " " @.60 1 80

5 65

15% Overhead

85

COST

22 85

Labor

CHARGE 40' @ .75 is 30.00, but he deposited 28.50, so call it

\$28 50

38  
75  
190  
266  
28.50

DATE May 22, 1931

TOWN OF LEXINGTON—BOARD OF PUBLIC WORKS

WATER DIVISION

The undersigned applies for a supply of water at No. 147<sup>#6</sup> Middle St. St. and hereby agrees to comply with the rules and regulations as now, or at any future time, established by the Board of Selectmen.

Am't. of Estimate \$ 28<sup>50</sup>


Owner Victor Olson

Am't. Paid \$ 28<sup>50</sup>

Address 45 Dartmouth Court  
Everett, Mass.

Builder \_\_\_\_\_

Sketch of Service Here

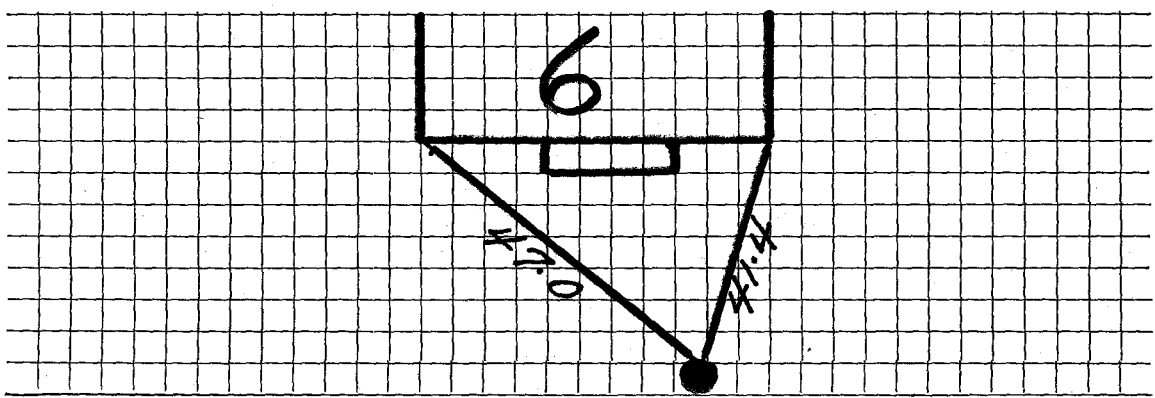

Connection made in \_\_\_\_\_ Street.

Work completed \_\_\_\_\_ 19

Remarks:

*Victor Olson  
45 Dartmouth Court, Everett*