


DATE 22 JULY 1995

TOWN OF LEXINGTON — BOARD OF PUBLIC WORKS

WATER DIVISION

Sketch of Service Here

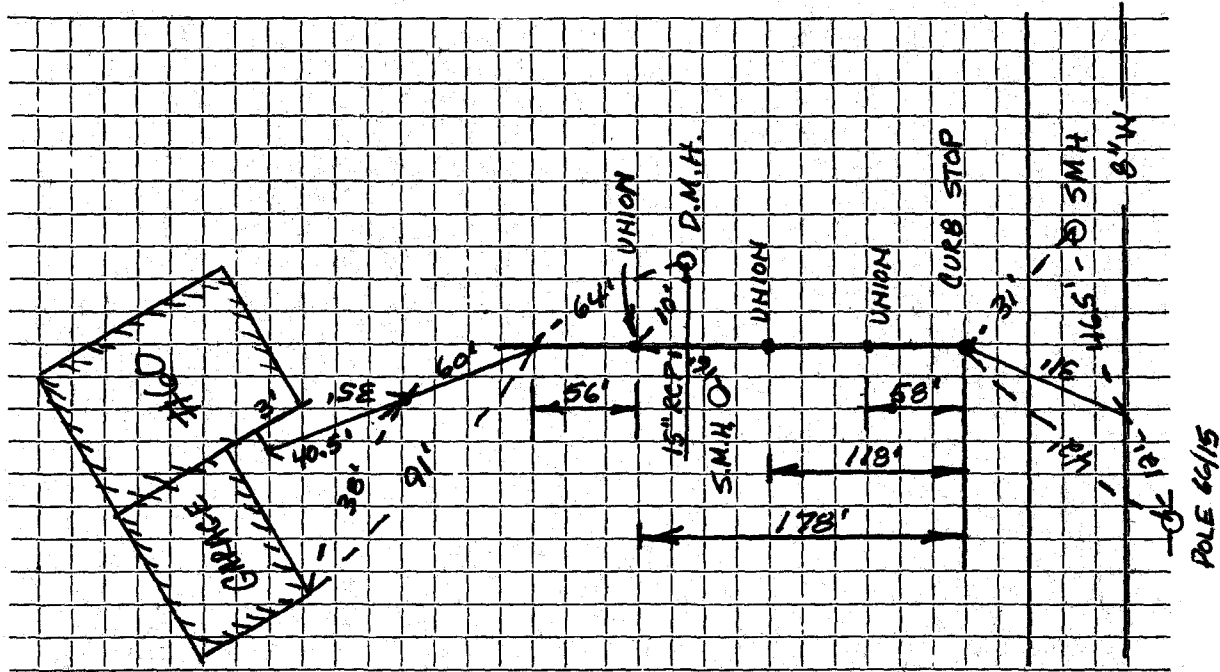

Connection made in MIDDLE STREET Street.

Work completed J.M. MCLAUGHLIN, INC.

Remarks: