

WATER SERVICE RECORD

Name Roscoe Stände

Service No. 115

Address 62 Middle Street

Location

~~Repair~~ ~~Removal~~ - New Service


Comm. 12-9-57

Date	Material	Amount	Total	Date	Amount
6/12/57	labor	29 41		6-6-57	Deposit \$ 100 00
	10% overhead	2 94		12-2-57	Refund 3 69
			32 35		\$ 96 31
	60' 3/4" copper tubing @ .375		22 50		NON CHARGE
	1 3/4" Cx 1/2 IWH stop & waste		4 96		LABOR 15 19
	1 1/2 hr. town shovel @ 6.50		9 75		
	1 hrs. trucking @ .75		75		31' 3/4" copper tubing @ .375 11 63
	1 hr. trucking @ 3.00		3 00		1 3/4" C corp cock 4 64
	1 hr. Rodgers trailer @ 3.00		3 00		1 3/4" curb cock 5 94
	20 x 3 patch		20 00		1 box & rod 4 62
			96 31		1 1/2 straight tail pc. 50
					1 1/2 offset tail pc. 50
					1 hr trucking 75
					1/2 hr. town shovel 6.50 3 25
					WO*3861 47 02
				12-3-75	Change Over To New Main
					1 3/4" Corporation

DATE \_\_\_\_\_

TOWN OF LEXINGTON — BOARD OF PUBLIC WORKS  
WATER DIVISION

Sketch of Service Here

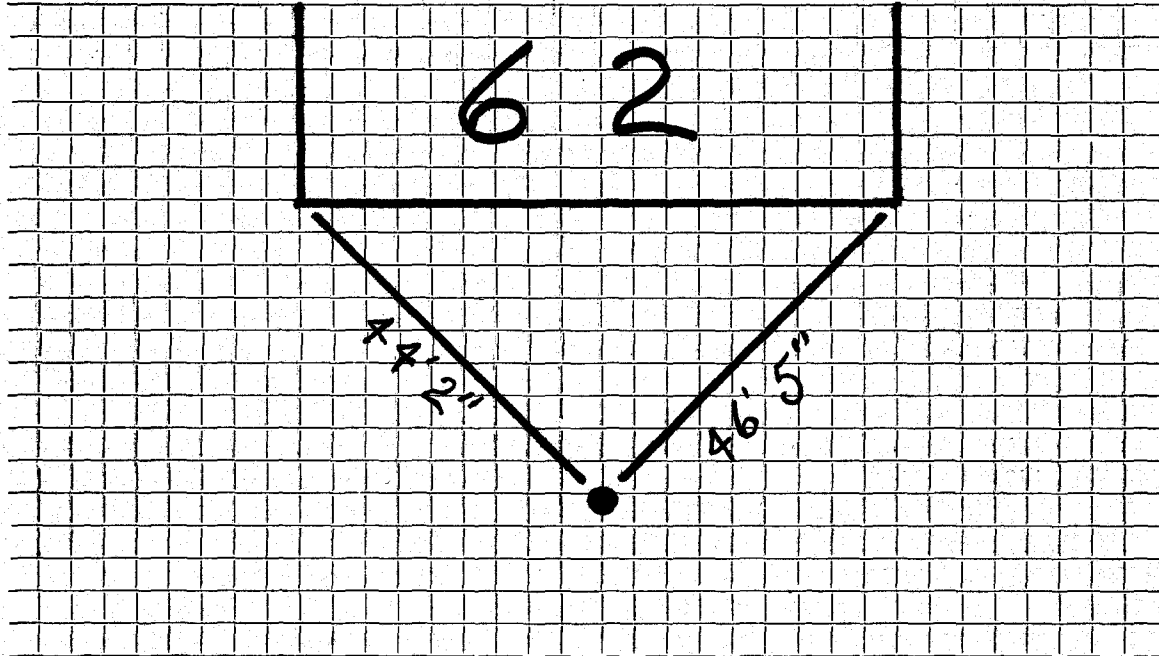

Connection made in ..... Street.                      Work completed .....

Remarks: .....  
.....  
.....