

Name Philip J. Gagnon *Waterdown Camp Back*

Service No. ~~28~~ 1994

Address 127 Lexington Ave., Cambridge
70 Middle St.

Location 70 Middle Street

Kind of Pipe Size Size of Main

~~Repair - Renewal~~ New Service

Location

Date	Material	Amount	Total	Date	Amount
P. 9-18-28 <i>for</i>	70 1" C.L. Pipe @ .27	18 90			
50.00 ✓ P. 12-31-28	4 1" L.L. Coup. @ .30	1 20		<i>Sept. 12 1928 - Cash</i>	30 00
<i>for</i> 12-32	1 1" L.L. Ell	35		<i>Feb. 7 1930 - Cash</i>	12 52
	1 1" Br. Sp. Nipple	25			
	1 S & W	3 00			
	Trucking	75	24 45		
<i>Hadley Press, Inc Lexington</i> /17/28	58 Hrs. Labor @ .55	31 90		<i>A. 11.5-13-29</i>	
	2 " " @ .60	1 20	33 10	<i>AR 11/1/29</i>	
	15% Overhead		4 97	<i>A. 11.1.30-30</i>	
			62 52		
	Labor				

DATE 4/3/28

Lot # 179

TOWN OF LEXINGTON—BOARD OF PUBLIC WORKS

WATER DIVISION

The undersigned applies for a supply of water at No. 70 Middle St. and hereby agrees to comply with the rules and regulations as now, or at any future time, published by the Board of Selectmen.

Am't. of Estimate \$ _____

Owner


Philip J. Gagnon

Am't. Paid \$ _____

Address

127 Lexington Ave
Sambidge

Builder owner

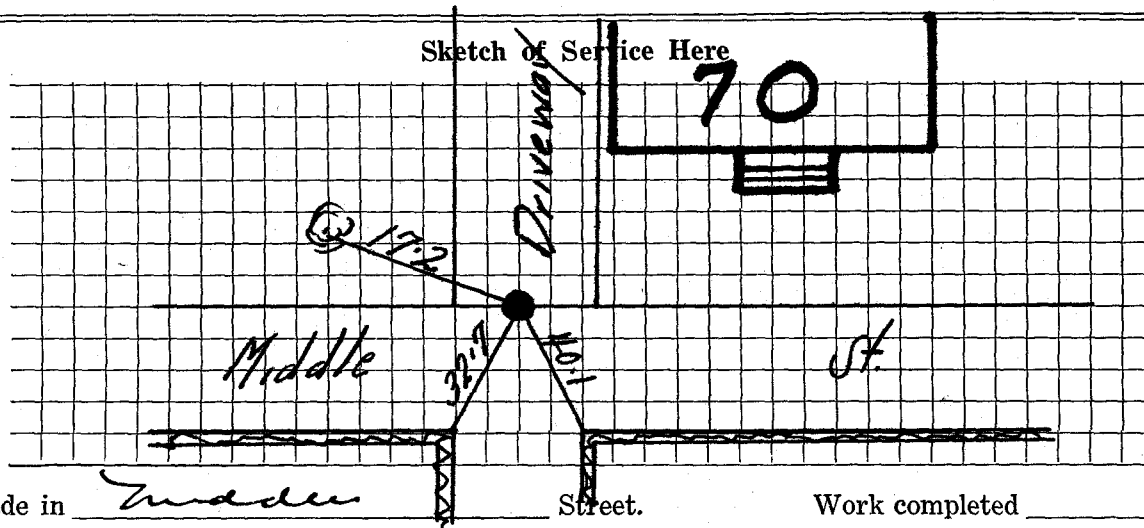

Connection made in Middle

Street.

Work completed _____

19

Remarks: