


DATE _____

TOWN OF LEXINGTON — BOARD OF PUBLIC WORKS

WATER DIVISION

Sketch of Service Here

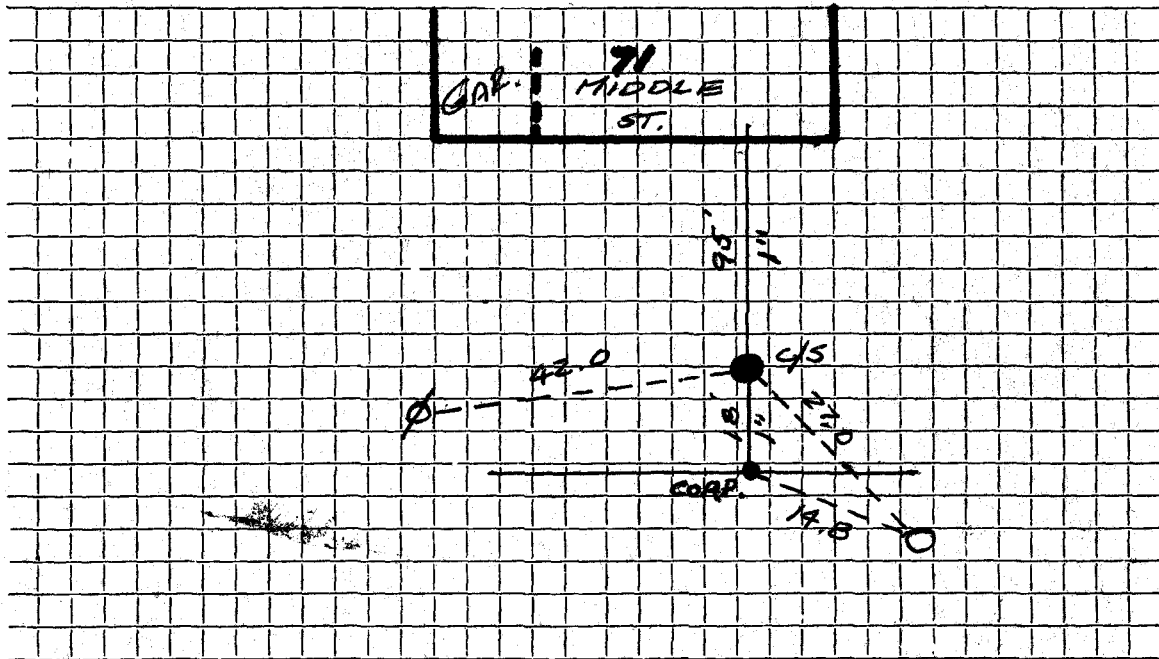

Connection made in MIDDLE..... Street. Work completed

Remarks: TOWN MADE TAP. CONTRACTOR DID PIPE WORK.....