

WATER SERVICE RECORD

Name Thomas Napoli

Service No. 178

Address 73 Middle Street (House)

Location

~~Repair - Renewal~~ - New Service

Comm. 10-28-57

Date	Material	Amount	Total	Date	Amount
8/28/57	labor	38 81		8-15-57	Deposit # 290 00
	10% overhead	<u>3 88</u>		10-28-57	Balance # 79 57
			42 69		# 120 43
100'	1" copper tubing @ .5202		52 02		NON CHARGE
1	1" C x 1" IWH stop & waste		5 60	8/28/57	labor 5 44
1	1" C 3 part union		3 12	14'	1 1/2" copper tubing @ .5202 7 28
2 1/2	hrs. town shovel @ 6.50		16 25	1	1" corp cock 5 94
1	hr. trucking @ .75		<u>75</u>	1	1" curb cock 4 64
			120 43	1	box & rod 4 62
				1	1" straight tail piece 50
				1	1" offset tail piece 50
				1	hr trucking @ .75 75
				1/2	hr town shovel @ 6.50 3 25
				6	x 3 patch 6 00
					<u>38 92</u>


* \$54.72 applied to W. H.C. # 136

10-20-57

TOWN OF LEXINGTON — BOARD OF PUBLIC WORKS

WATER DIVISION

Sketch of Service Here

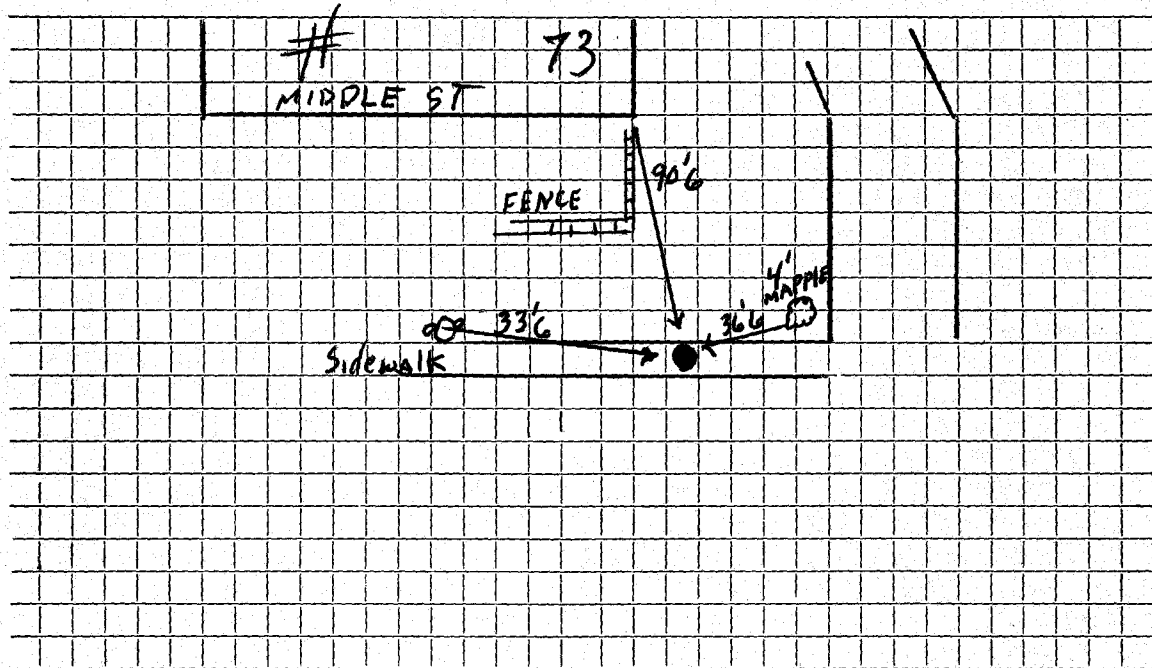

Connection made in Street. Work completed

Remarks:

.....

.....