

Name Vincent Fopiano

Service No. 88 1996

Address 6 1/2 Muzzey St.,
74 middle st.

E 2521
#5568
#6958

Location

74 Middle St.,

Kind of Pipe

Size

Size of Main

Repair—Renewal—New Service

Location

Date	Material	Amount	Total	Date	Amount
Dec. 1940	21 hrs. @ 55¢	11 55		November 1940 Deposited	65 00
Jan 17. 31-40	45 " @ 60¢	27 00	38 55	Dec 31 1940 Refund	4 20
	10% Overhead		3 86		60 80
	56' 3/4" Copper tubing @ 19¢		10 64		
	1 3/4" S. & W.		2 25		
	2 hrs. trucking @ 75¢		1 50		
	Trench repairs		4 00		
			60 80		
	Labor				

Hadley Press, Inc., Lexington

DATE Nov 7 1957

TOWN OF LEXINGTON—BOARD OF PUBLIC WORKS

WATER DIVISION

The undersigned applies for a supply of water at No. 74 Maple St St. and hereby agrees to comply with the rules and regulations as now, or at any future time, established by the Board of Selectmen.

Am't. of Estimate \$ 25.00


Owner _____

Am't. Paid \$ _____

Address _____

Builder _____

Sketch of Service Here

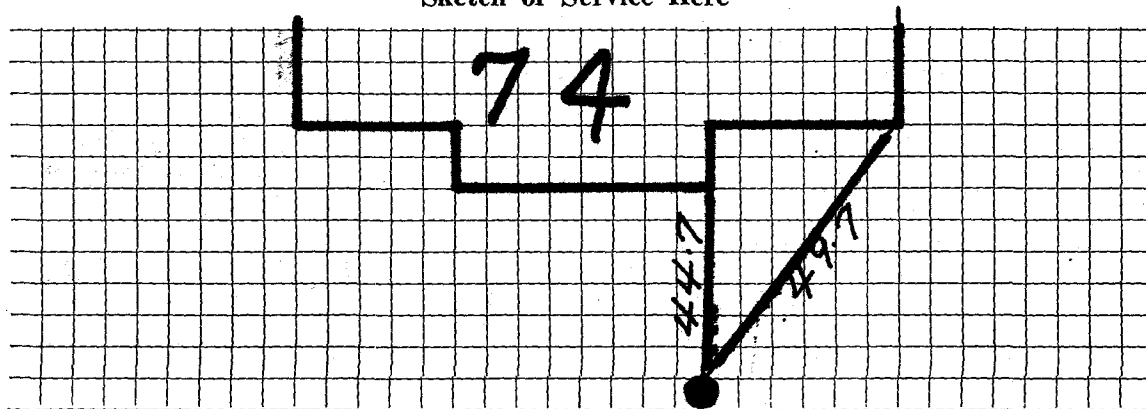

Connection made in _____ Street.

Work completed _____ 19

Remarks: