

Name Lyman E. Carlow

Service No. ~~55~~ 1997

Address 239 Leyden Street, <sup>EAST</sup> Boston, Massachusetts  
76 Middle St.

# 5628  
# 6219  
# 6220  
# 6434

Location 76 Middle Street

Kind of Pipe

Size

Size of Main

~~Repair - Renewal~~ - New Service

Location

Date 1939	Material	Amount	Total	Date	Location	Amount
Oct. 14,	4 hrs. @ 60¢	2 40		October 12 1939	Deposited	68 00
Com 12.26 39	10% Overhead	<u>24</u>	2 64	<del>December 18 1939</del>	Refunded	<u>2894</u>
	96' 3/4" Copper tubing @ 16¢	15 36	15 36			39 06
	1 3/4" C.xI S. & W.	2 10	2 10			
	1 3/4" C. Union ( 3 part)		90			
	2 hrs. trucking @ 75¢	1 50	1 50			
	Trench repairs	<u>16 56</u>	<u>16 56</u>			
			39 06			
	Labor					

Hadley Press, Inc., Lexington

DATE Sept 11 1939

# TOWN OF LEXINGTON—BOARD OF PUBLIC WORKS

95'

## WATER DIVISION #76

The undersigned applies for a supply of water at No. lot #152 Middle St. and hereby agrees to comply with the rules and regulations as now, or at any future time, established by the Board of Selectmen.


Am't. of Estimate \$ Owner 68<sup>00</sup> } includes } Owner  
Town 150<sup>00</sup> }  
} Water 16

Lynnan E. Carlow  
239 Leyden St  
E. Boston Mass

Am't. Paid \$ \_\_\_\_\_ Address \_\_\_\_\_

Builder \_\_\_\_\_

Sketch of Service Here

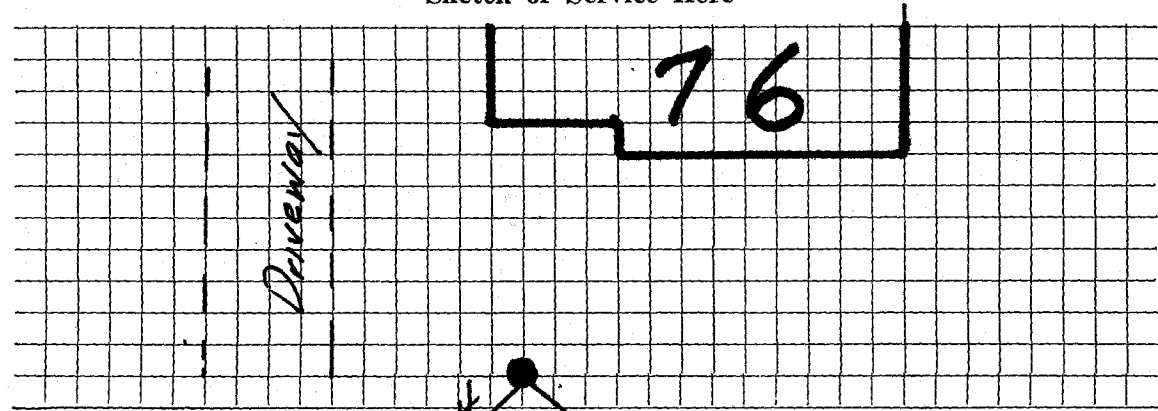

Connection made in \_\_\_\_\_ Street \_\_\_\_\_ Work completed \_\_\_\_\_ 19

Remarks:

