

WATER SERVICE RECORD

Name

Service No. 1952

Address 84 Middle ST

Location T. D. W. P.


Repair—Renewal—New Service J. McLaughlin

Date	Material	Amount	Total	Date	Material	Amount
11/8/05	75' 1" Copper			9/3/41	3/4 Copper	
	1 3/4 x 1" In creaser				3/4 Corp	
	buff lo box				3/4 Carb STOP	
				1975	Repair	
					3/4 Corp	
					3' copper	
					1 Style 88 UNION	

DATE _____

TOWN OF LEXINGTON — BOARD OF PUBLIC WORKS
WATER DIVISION

Sketch of Service Here

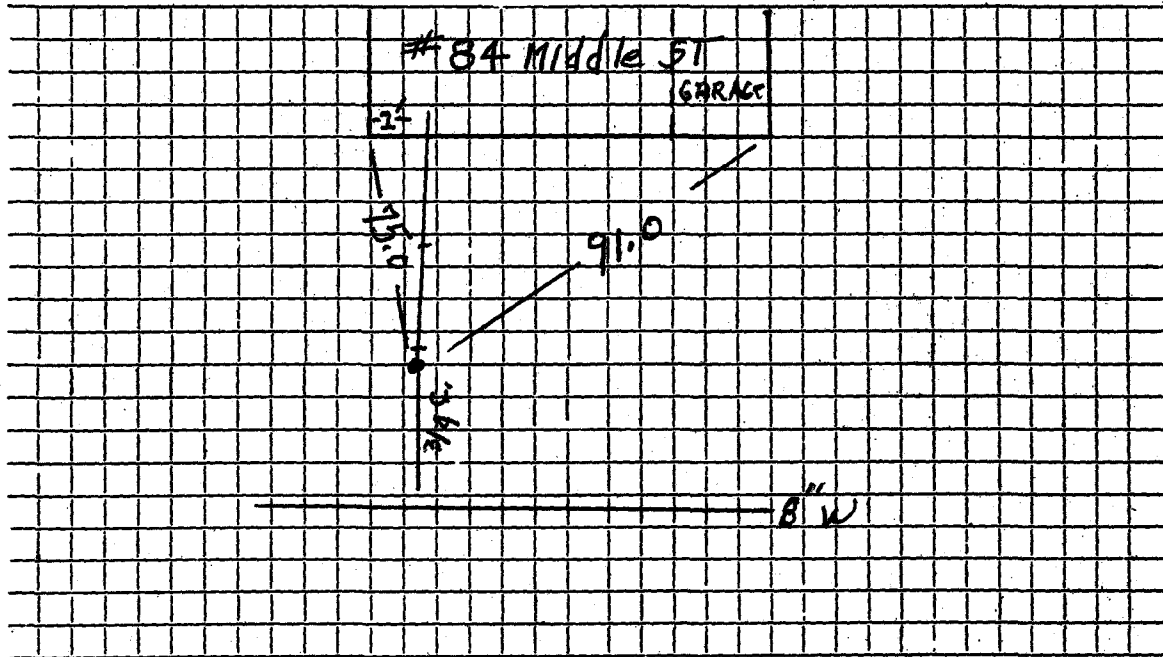

Connection made in Street. Work completed

Remarks:

.....

.....