

Name William Clark *Owner (Deposit paid by H.M. Sweetser Service No. 25/999
 98 Cross St., Malden.

Address 65 Chetwynd St., Somerville
 86 Middle St.

Location Lots 183;184;185 Middle St., #86

Kind of Pipe Size Size of Main

Repair—Renewal—New Service Location

Date 1937

6/5/37

on 7/29/37

Date	Material	Amount	Total	Date	Location	Amount
	2 hrs. @ 60¢		1 20			85 00
	120' 3/4" Cop. Tubing @ 25¢		30 00	May 27/1937	Deposited	8 68
	1 3/4" Cop. Union		50			76 32
	1 3/4" S. & W.		3 75			
	2 hrs. trucking @ 75¢		1 50			
			36 95			
	Flat Rate:					
	120' @ 50¢		60 00			
	Construction Charge		3 00			
	Patching 20 x 5 @ 200		13 32			
			76 32			
	Labor					

Hadley Press, Inc., Lexington

TOWN OF LEXINGTON—BOARD OF PUBLIC WORKS

WATER DIVISION

The undersigned applies for a supply of water at No. 86 Middle St. St. and hereby agrees to comply with the rules and regulations as now, or at any future time, established by the Board of Selectmen.

Am't. of Estimate \$ # 85⁰⁰


Owner Wm. Clark

Am't. Paid \$ _____

Address 65 Chelmsford Rd
Somerville Mass

Builder H. M. Sweetser
98 Cross St. Malden

Sketch of Service Here

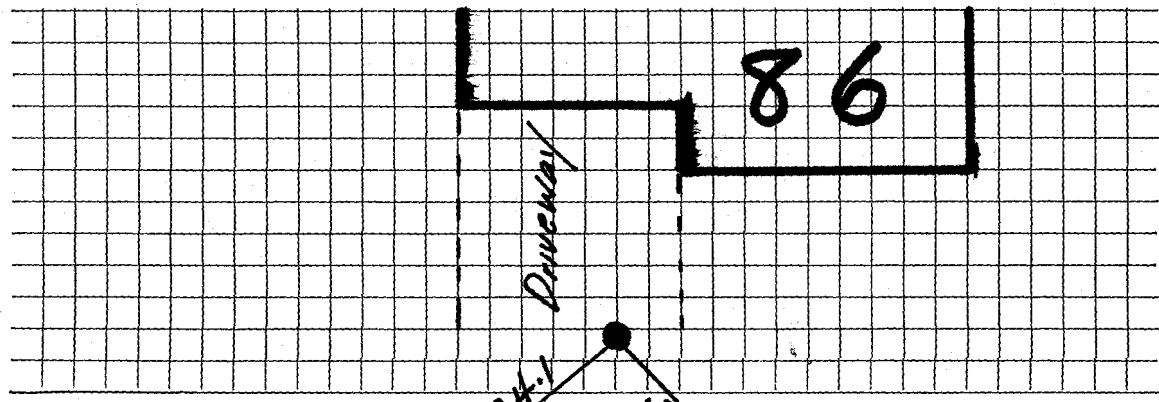

Connection made in _____

Street.

Work completed _____

Remarks:

86 Middle St