

Name George A. Woods

Service No. ^{# 4348} ~~34~~ 2000

Address 60 Hemlock Street

Lexington
88 middle St.

Location 88 Middle St.,

Kind of Pipe

Size

Size of Main

Repair—Renewal—New Service

Location

Date
1940

Material

Amount

Total

Date

Amount

July 30

4 hrs. @ 60¢

2 40

July 24 1940 Deposited

36 00

10% Overhead

24

2 64

October 2, 1940 Refunded

13 11

40' 3/4" Copper tubing @ 18

7 20

22 89

1 3/4" C.x 1/2" I.S. & W.

2 25

1 3/4" C. Union (3 part)

90

1 hr. trucking

75

trench repairs

9 15

22 89

Labor

DATE July 24, 1940

TOWN OF LEXINGTON—BOARD OF PUBLIC WORKS

WATER DIVISION

The undersigned applies for a supply of water at No. 88 Middle St. and hereby agrees to comply with the rules and regulations as now, or at any future time, established by the Board of Selectmen.

Am't. of Estimate \$ 36.00

Owner

George A. Wood

Am't. Paid \$ _____


Address

60 Hemlock St.

Builder Carl Peterson

Wilmington

Sketch of Service Here

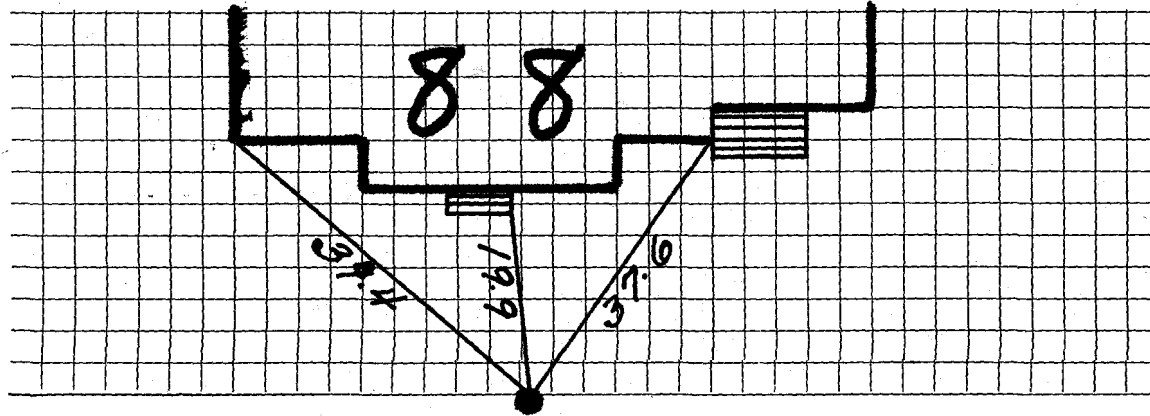

Connection made in _____ Street.

Work completed _____ 19

Remarks: