

WATER SERVICE RECORD

Name: William H. Sullivan

Service No. 4

Address 92 Middle Street #3062

#7449

Location

~~Repair~~ ~~Overhead~~ New Service

Com. 3-15-54

Date	Material	Amount	Total	Date	Amount
3/1/54	Labor	6 08		1-6-54	Deposited 65 00
	10% overhead	61	6 69	3-15-54	Refunded 3 64
	48' - 3/4" copper tubing @ .3629	17 42			<u>NON CHARGE</u> 61 36
	1 - 3/4" C x 1/2 I.W.H. stop & waste	4 00		3/1/54	Labor 16 08
	3 hrs. Littlefield shovel @ 7.50	22 50			20' - 3/4" copper tubing @ .3629 7 26
	1 hr. trucking	75			1 - 3/4" C. corp-cock 4 33
	patching 10 x 3	10 00			1 - 3/4" C x 3/4" C. curb-cock 4 67
			61 36		1 box and rod 3 90
					1 - 1/2 offset tail pc. 50
					1 - 1/2 straight tail pc. 50
					2 hrs. Littlefield shovel @ 7.50 15 00
					1 hr. trucking 75
					<u>52 99</u>

DATE _____

TOWN OF LEXINGTON — BOARD OF PUBLIC WORKS

WATER DIVISION

Sketch of Service Here

A large rectangular grid of graph paper, consisting of 20 columns and 20 rows, intended for sketching service details.

Connection made in Street. Work completed

Remarks:

.....

.....

WATER SERVICE RECORD

Name .

Service No.

Address 92 MIDDLE ST

Location CORPORATION OFF 12" MAIN ON MIDDLE ST.

Repair - ~~Renewal~~ - New Service WATER MAIN CLEANING & LINE PROJECT C99-02 : Biszko Co.


Date	Material	Amount	Total	Date	Amount
				8-5-1999	
				5' 1" COPPER BTW CORPORATION & UNION	
				1 CORPORATION	
				1 UNION	

DATE 8-5-1999

TOWN OF LEXINGTON — BOARD OF PUBLIC WORKS

WATER DIVISION

Sketch of Service Here

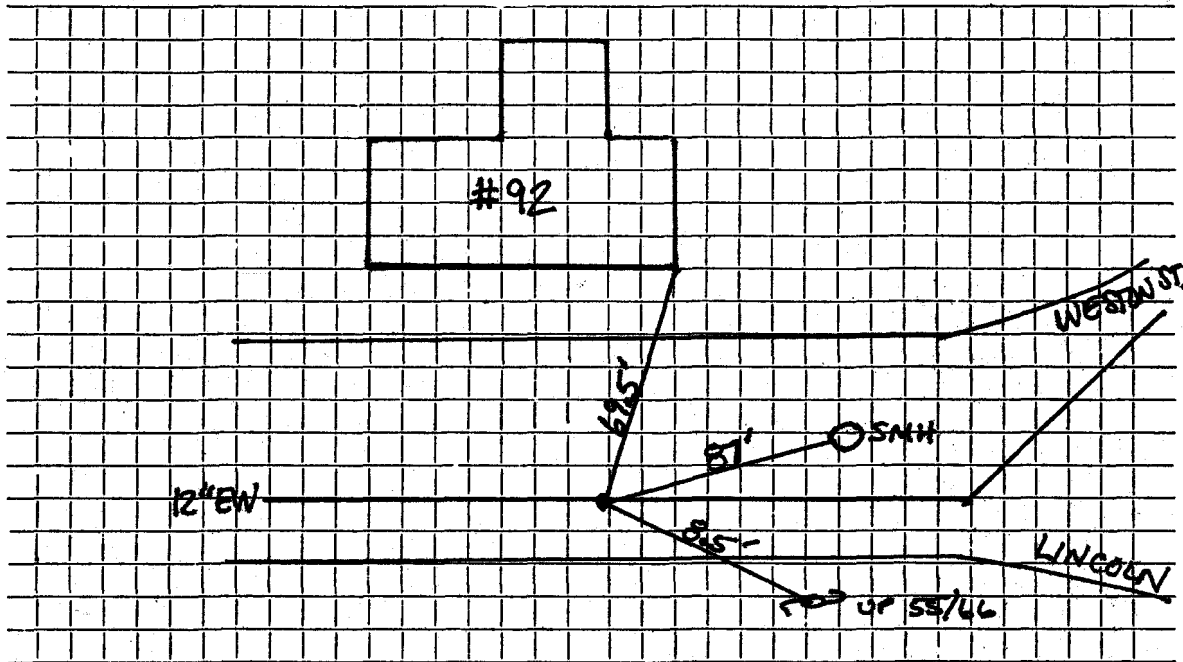

Connection made in 12" MAIN ON MIDDLE ST. Street. Work completed NEW CORPORATION, UNION

Remarks: