

WATER SERVICE RECORD

Name Donald K. Irwin

Service No. 316 #4816
#5496

Address 9 1/2 Middle Street

Location Lexington, Mass.


~~Repair & Renewal~~ - New Service Com. 12-26-50

Date	Material	Amount	Total	Date	Amount	
Nov. 2, '50	Labor	4 00	4 00	<i>Oct 1950</i>	<i>Repaired</i>	50 00
	10% Overhead		40			
	50' - 3/4" Copper Tubing @.32	16 00	16 00		No Charge	48 91
	1 - 3/4"C x 1/2" I.W.H. S&W	3 76	3 76	Nov. 12, '50	Labor	8 83
	Littlefield Shovel 2 hrs. @7.00	14 00	14 00		20' - 3/4" Copper Tubing @.32	6 40
	Trucking 1 hr. @.75	75	75		1 - 3/4"C Corp-cock	3 60
	Patching 10 x 3	10 00	10 00		1 - 3/4"C x 3/4"C Curb-cock	4 40
			48 91		1 - Box & Rod	3 35
					1 - 1/2" Offset Tail Piece	42
					1 - 1/2" Straight Tail Piece	42
					Littlefield Shovel 2 2/3 hrs. @7.00	18 66
					Trucking 1 hr. @.75	75
						46 83
				5/12/86	1- 12" style 160 bell joint clamp	
					18 yds gravel	
					cold patch	

DATE _____

TOWN OF LEXINGTON — BOARD OF PUBLIC WORKS
WATER DIVISION

Sketch of Service Here

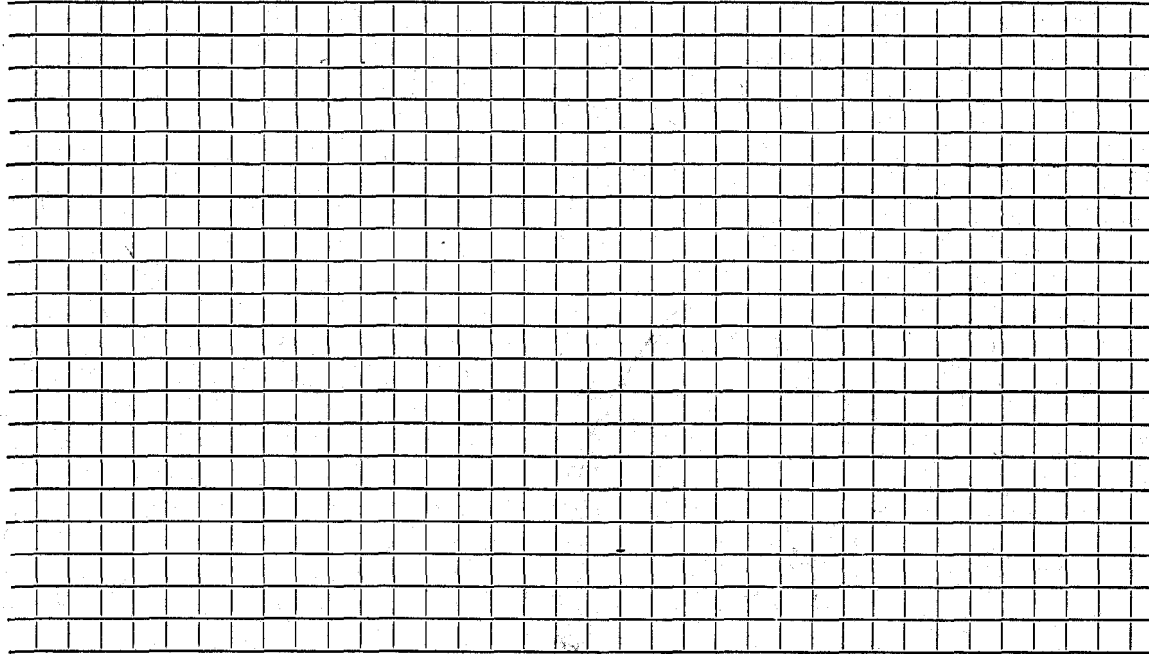


Connection made in Street. Work completed

Remarks:
.....
.....

DATE 8-4-1999

TOWN OF LEXINGTON — BOARD OF PUBLIC WORKS
WATER DIVISION

Sketch of Service Here

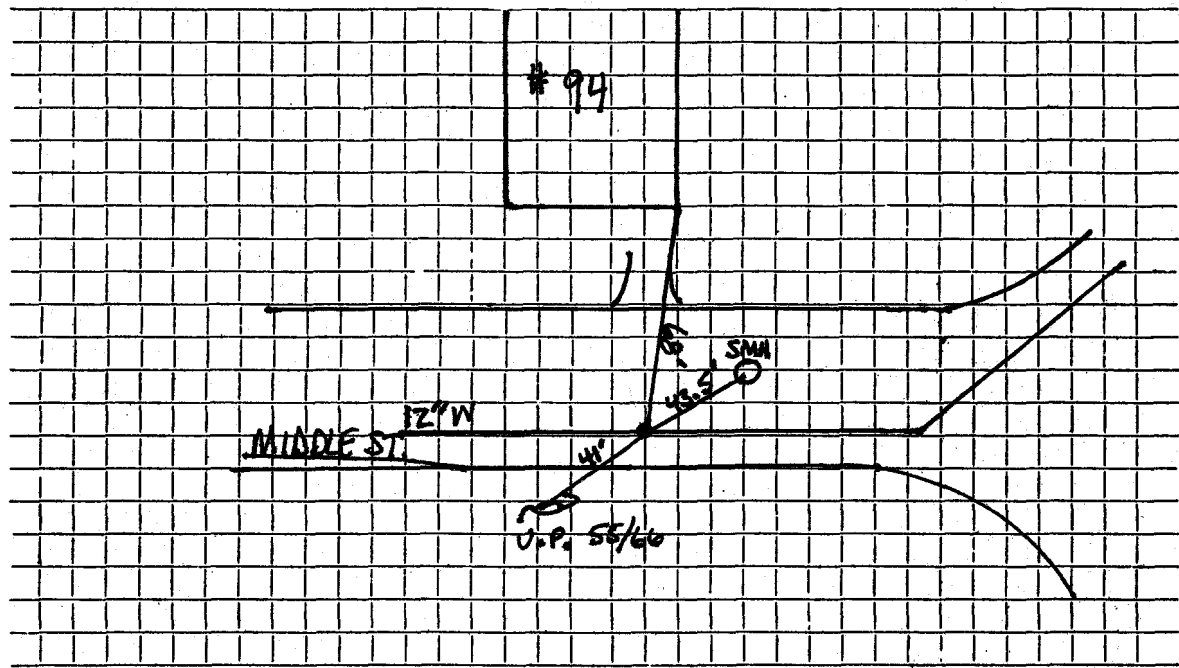

Connection made in 12" MAIN ON MIDDLE ST. Street. Work completed NEW CORPORATION, UNION

Remarks: