




DATE 2/21/2020

TOWN OF LEXINGTON — BOARD OF PUBLIC WORKS

WATER DIVISION

Sketch of Service Here

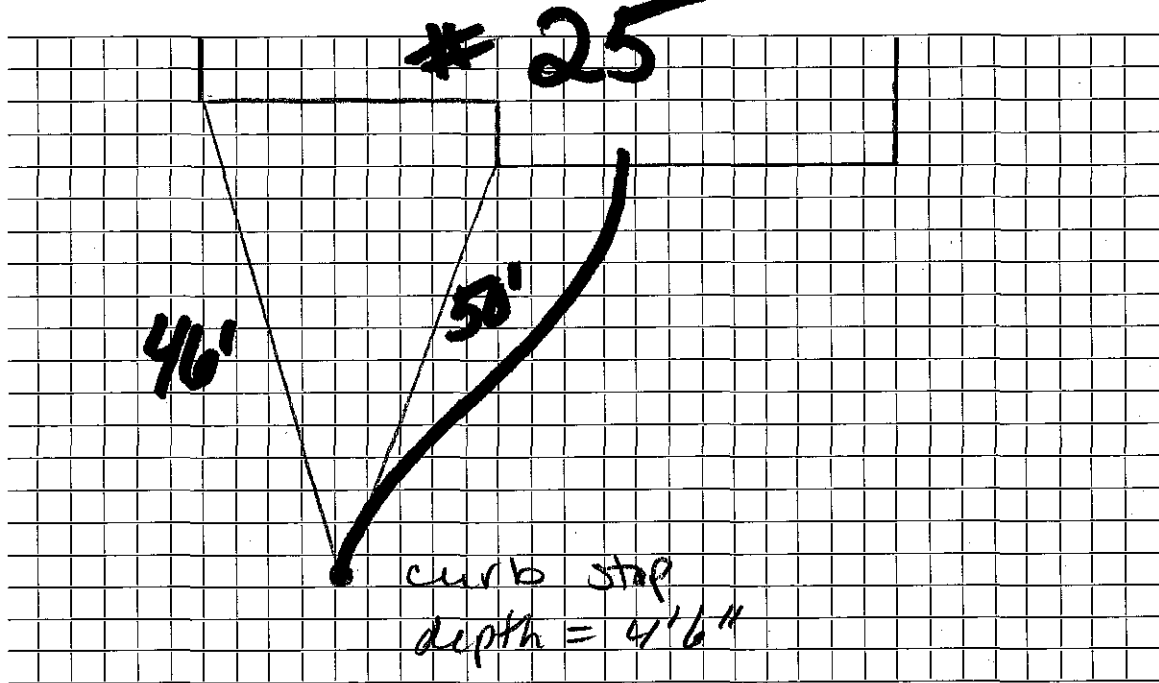

Connection made in Middleby Street. Work completed .....

Remarks: .....