

Name Guy Spuria

Service No. 269

Address 12 Middleby Road

Lexington, Mass.

Location 12 Middleby Road

Kind of Pipe

Size

Size of Main

~~XXXXXXXXXX~~ New Service

Com. 12-31-19

Location

| Date          | Material                         | Amount | Total        | Date                             | Amount       |
|---------------|----------------------------------|--------|--------------|----------------------------------|--------------|
| Sept. 16, '49 | Labor                            | 4 90   | 4 90         |                                  |              |
|               | 10% Overhead                     |        | 49           |                                  |              |
|               | 36' - 3/4" Copper Tubing @.24    |        | 8 64         | Mar 14 '50                       |              |
|               | 1 - 3/4"C x 1/2" I.W.H. S&W      |        | 3 29         |                                  |              |
|               | Littlefield Shovel 2 hrs. @ 7.00 |        | 14 00        |                                  |              |
|               | Trucking 1 hr. @.75              |        | 75           |                                  |              |
|               |                                  |        | <u>32 07</u> |                                  |              |
|               | Bill Sent 1-5-50                 |        |              |                                  |              |
|               |                                  |        |              | Sept. 16, '49                    |              |
|               |                                  |        |              | Labor                            | 4 90         |
|               |                                  |        |              | 28' - 3/4" Copper Tubing @.24    | 6 72         |
|               |                                  |        |              | 1 - 3/4"C Corp-cock              | 3 15         |
|               |                                  |        |              | 1 - 3/4"C x 3/4"C Curb-cock      | 3 85         |
|               |                                  |        |              | 1 - 3/4"C x 3/4"C Union (3pts)   | 1 39         |
|               |                                  |        |              | 1 - Box & Rod                    | 3 75         |
|               |                                  |        |              | 1 - 1/2" Offset Tail Piece       | 37           |
|               |                                  |        |              | 1 - 1/2" Straight Tail Piece     | 37           |
|               |                                  |        |              | Littlefield Shovel 2 hrs. @ 7.00 | 14 00        |
|               | Labor                            |        |              | Trucking 1 hr. @.75              | 75           |
|               |                                  |        |              |                                  | <u>39 25</u> |

*No Deposit Paid*

No Charge

TOWN OF LEXINGTON – BOARD OF PUBLIC WORKS

**WATER DIVISION**

The undersigned applies for a supply of water at No..... St. and hereby agrees to comply with the rules and regulations as now, or at any future time, established by the Board of Selectmen.

Am't of Estimate \$.....

Owner .....


Am't Paid \$.....

Address .....

Builder .....

.....

Sketch of Service Here

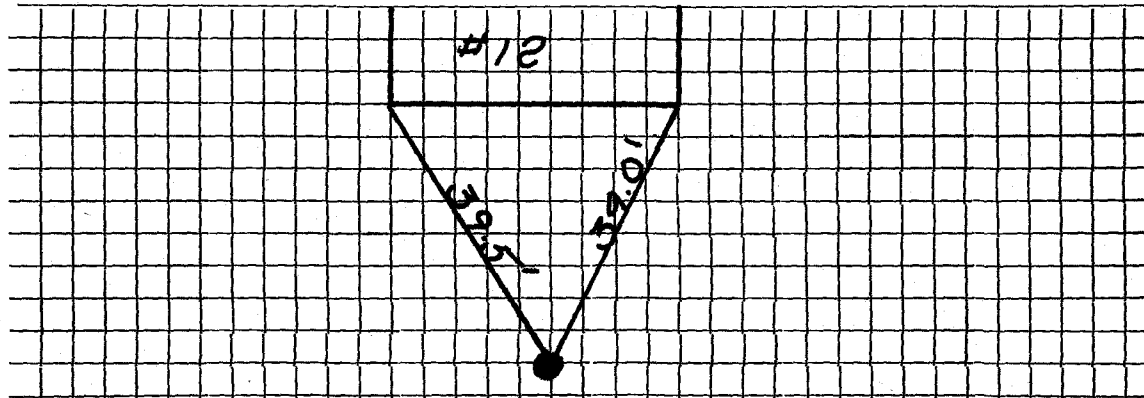

Connection made in ..... Street.

Work completed .....19

Remarks: