

Name Louise M. Hannafo.

Service No. 25 2003

Address 170-172 Middleby Road

Location

Kind of Pipe Size Size of Main

~~Repair-Removal~~ New Service

Location

Date	Material	Amount	Total	Date	Amount
7/14/32	20' 1" C.L. Pipe @.27	5 40			
<i>Comp. 30.00 8-16-32</i>	2 1" L.L. Coup. @.25	50			
	1 1" Er. Sp. Nip.	15			
	1 1" L.L. E11	35			
	1 S & W	3 00			
	Trucking	75	\$10 15		
	26 Hrs. Labor @.55	14 30			
	3 " " @.60	1 80	16 10		
	15% Overhead		<u>2 41</u>		
	Labor		28 66		
CHARGE	20 ft. @ \$1.50	\$30 00	\$30 00		

Sept.

8 1932 - Cash 30 -

NON CHARGE

5-1-62	12' 3/4" Copper tubing @.42	5.04	
	1 3/4" C Adapter	1.62	
	1 1" x 3/4" 2 part union	1.72	
	1 1" Style 38 Repair Clamp	2.35	
	1 1" x 6" C.L. Nipple	.34	
	1 hr. Trucking @.75	<u>.75</u>	
	(Repair to service)	11.72	

Hadley Press, Inc., Lexington

DATE July 13, 1932

TOWN OF LEXINGTON - BOARD OF PUBLIC WORKS WATER DIVISION

170-172

The undersigned applies for a supply of water at No. Middleby Rd. St. and hereby agrees to comply with the rules and regulations as now, or at any future time, established by the Board of Selectmen.

Am't. of Estimate \$ _____

Owner

John W. Harford


Am't. Paid \$ _____

Address

Middleby Road
Lexington, Mass.

Builder _____

Sketch of Service Here

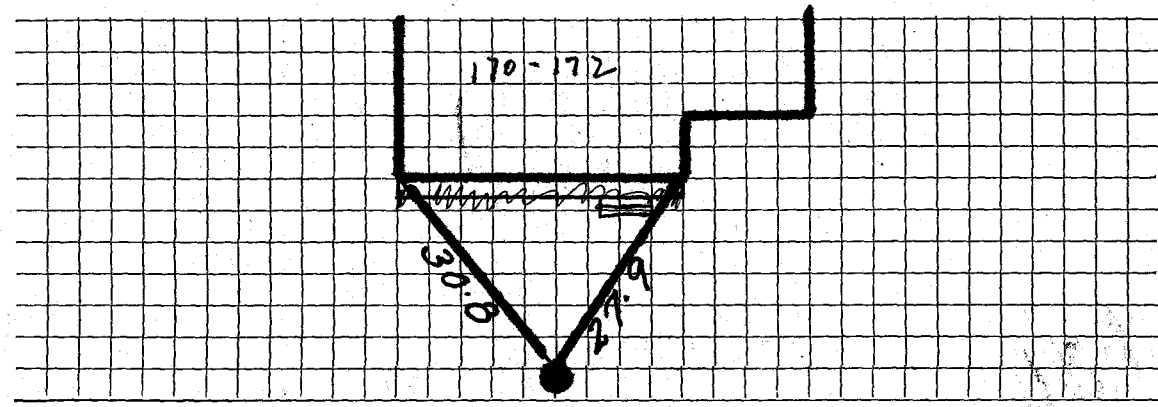

Connection made in _____ Street.

Work completed _____ 19

Remarks: