

WATER SERVICE RECORD

Name Brookside Bldg. Trust

Service No. 75

Address 19 Middleby Rd.

Location Lexington


~~REPAIR WORK~~ - New Service COM. 5-18-53

Date	Material	Amount	Total	Date	Amount
4/24/53	Labor	7 00		4-17-53 Deposited	50 -
	10% overhead	70	7 70	5-18-53 Refunded	(69)
	46' - 3/4" Copper tubing @.34		15 64		NON-CHARGE 43 29
	1-3/4" C x 1/2 I.W.H. stop & waste	4 00	4 00	4/24/53 Labor	7 25
	2 Hr. Littlefield Shovel	7.50	15 00	12' - 3/4" Copper Tubing @.34	4 08
	1 Hr. Trucking		75	1-3/4" C. Corp-cock	4 33
			43 09	1-3/4" C. x 3/4" C. Curb-cock	4 67
				1-Box & Rod	3 90
				1-1/2 offset tail piece	50
				1-1/2 Straight tail piece	50
				1 Hr. Littlefield Shovel	7 50
				1 Hr. Trucking	75
					33 18
				8-30-66 Lower Water Service-WO 3168	
				11' 3/4" Copper	

DATE _____

TOWN OF LEXINGTON — BOARD OF PUBLIC WORKS

WATER DIVISION

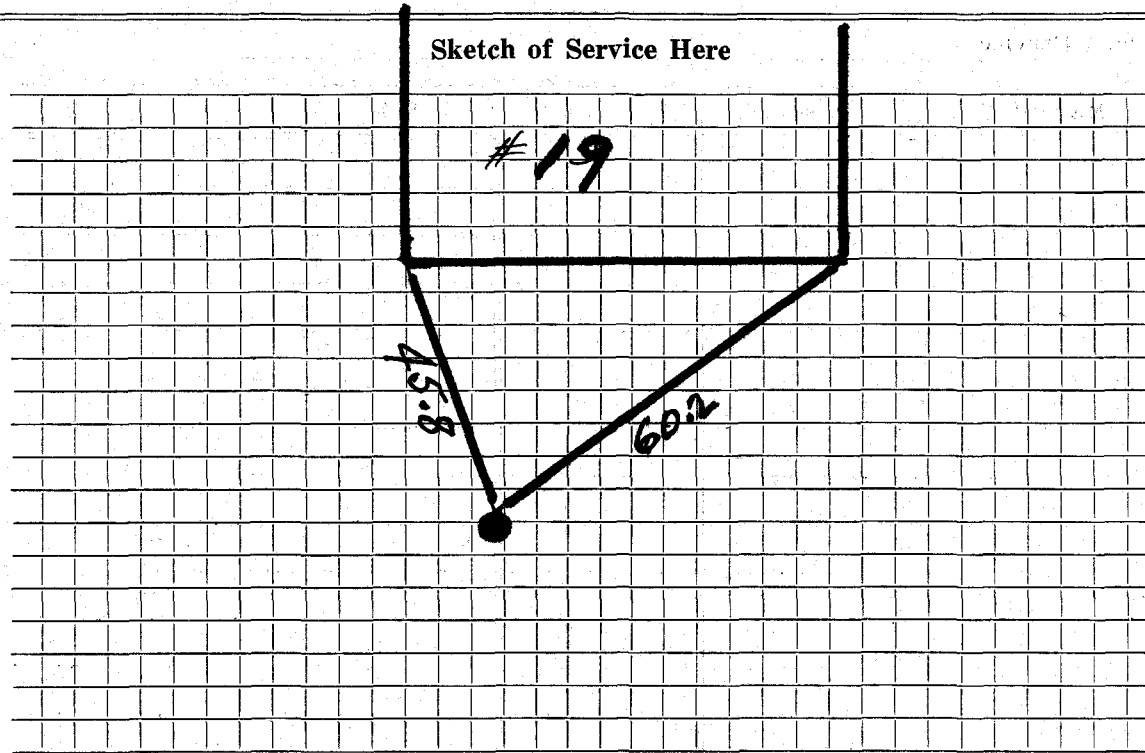

Connection made in Street. Work completed

Remarks:

.....

.....