

Name James Pierce

Service No. 183

Address 20 Middleby Road

Lexington, Mass.

Location 20 Middleby Road

Kind of Pipe

Size

Size of Main

~~XXXXXX~~ New Service

Com. 11-8-49

Location

Date	Material	Amount	Total	Date	Amount
Sept. 23, '49	Labor	1 35	1 35	Sept 23 '49	20 00
	10% Overhead		14	Nov 17 '49	6 77
	32' - 3/4" Copper Tubing @.24		7 68		13 21
	1 - 3/4" C x 1/2" I.W.H. S&W		3 29	Sept. 23, '49	10 55
	Trucking 1 hr. @.75		75	27' - 3/4" Copper Tubing @.24	6 48
			13 21	1 - 3/4" C Corp-cock	3 15
				1 - 3/4" C x 3/4" C Curb-cock	3 85
				1 - Box & Rod	3 75
				1 - 1/2" Offset Tail Piece	37
				1 - 1/2" Straight Tail Piece	37
				Littlefield Shovel 2 hrs. @ 7.00	14 00
				Trucking 1 hr. @.75	75
	Labor				43 27
				8-30-66 Lower Service	W03169

DATE _____

TOWN OF LEXINGTON – BOARD OF PUBLIC WORKS

WATER DIVISION

The undersigned applies for a supply of water at No..... St. and hereby agrees to comply with the rules and regulations as now, or at any future time, established by the Board of Selectmen.

Am't of Estimate \$.....

Owner


Am't Paid \$.....

Address

Builder

.....

Sketch of Service Here

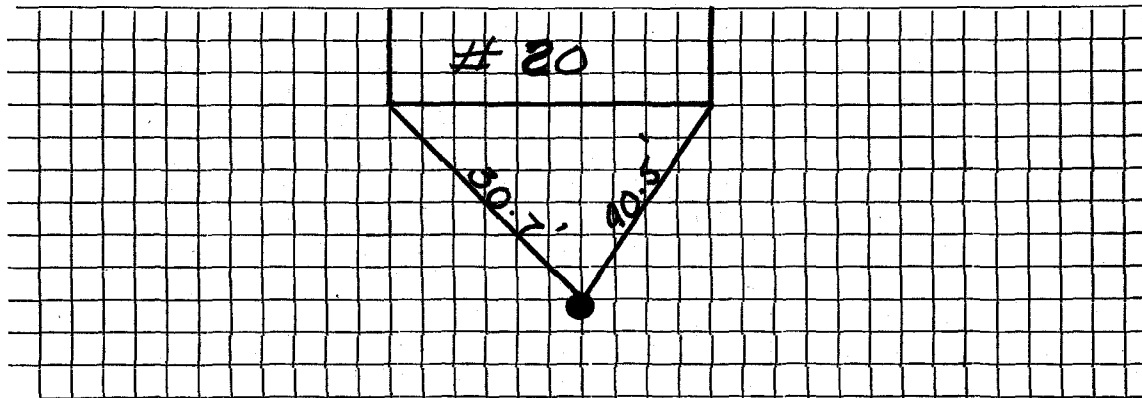

Connection made in Street.

Work completed19

Remarks: