

Name K. V. Wolsey

Service No.

3228

Address 24 Middleby Road

Lexington, Mass.

Location 24 Middleby Road

Kind of Pipe

Size

Size of Main

~~Repair~~ ~~Renewal~~ - New Service Com. 8-23-48

Location

Date	Material	Amount	Total	Date	Location	Amount
June 10, '48	Labor	1 15	1 15	June 7, '48	Deposited	30 00
	10% Overhead		12	Aug 20, '48	Refunded	27 25
	2 - 3/4" x 1/2" Bushings		70		Non-Charge	2 72
	Trucking 1 hr. @ .75		75	June 10, '48	Labor	5 15
			2 72	26' - 3/4" Copper Tubing @ .255		6 63
	Pipe supplied and laid by owner			1 - 3/4" Corp-cock		3 00
				1 - 3/4" C x 3/4" C Curb-cock		3 68
				1 - Box & Rod		3 55
				2 - 1/2" Straight Tail Pieces		60
				Trucking 1 hr. @ .75		75
				Littlefield Shovel 4 hrs. @ .700		28 00
						51 36
	Labor					

TOWN OF LEXINGTON—BOARD OF PUBLIC WORKS

WATER DIVISION

The undersigned applies for a supply of water at No. _____ St. and hereby agrees to comply with the rules and regulations as now, or at any future time, established by the Board of Selectmen.

Am't. of Estimate \$ _____


Owner _____

Am't. Paid \$ _____

Address _____

Builder _____

Sketch of Service Here

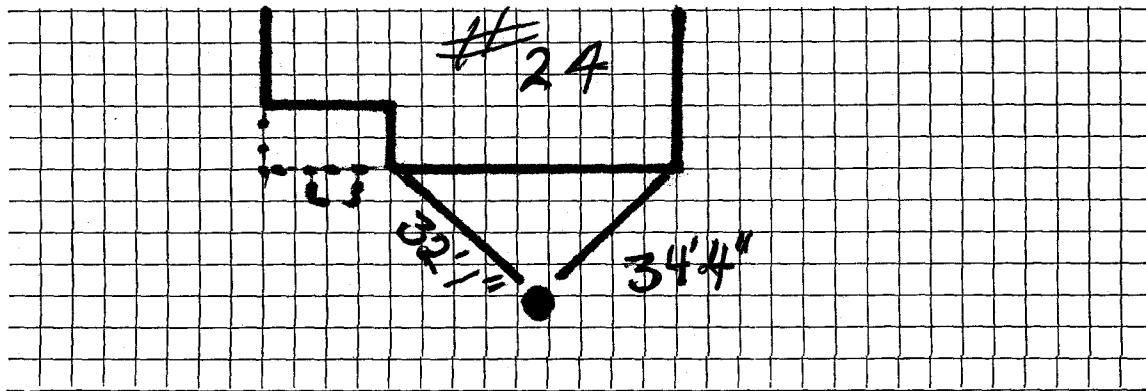

Connection made in _____ Street.

Work completed _____ 19

Remarks: