

Name Lloyd Lowe

Service No. 54

Address 28 Middleby Road

Lexington, Mass.

Location 28 Middleby Road

Kind of Pipe

Size

Size of Main

~~Renewal~~ - New Service

Com. 8-23-48

Location

Date	Material	Amount	Total	Date	Amount
May 16, '48	Labor	3 35	3 35	June 1, 48	35 00
	10% Overhead		34	Aug 20 48	20 41
	1 - 3/4" C x 1/2" I.W.H. S & W		3 15		14 59
	Trucking 1 hr. @ .75		75	May 16, '48	3 35
	Littlefield Shovel 1 hr. @ 7.00	7 00	7 00	28' - 3/4" Copper Tubing @ .255	7 14
			14 59	1 - 3/4" C Corp-cock	3 00
				1 - 3/4" C x 3/4" C Curb-cock	3 68
				1 - Box & Rod	3 55
				1 - 1/2" Straight Tail Piece	30
				1 - 1/2" Offset Tail Piece	30
	Pipe supplied by owner.			Littlefield Shovel 1 hr. @ 7.00	7 00
				Trucking 1 hr. @ .75	75
	Labor				29 07

Deposited
 Refunded
 Non-Charge

Hadley Press, Inc., Lexington

DATE _____

TOWN OF LEXINGTON—BOARD OF PUBLIC WORKS

WATER DIVISION

The undersigned applies for a supply of water at No. _____ St. and hereby agrees to comply with the rules and regulations as now, or at any future time, established by the Board of Selectmen.

Am't. of Estimate \$ _____

Owner _____


Am't. Paid \$ _____

Address _____

Builder _____

22 Highland St. Lowell Mass

Sketch of Service Here

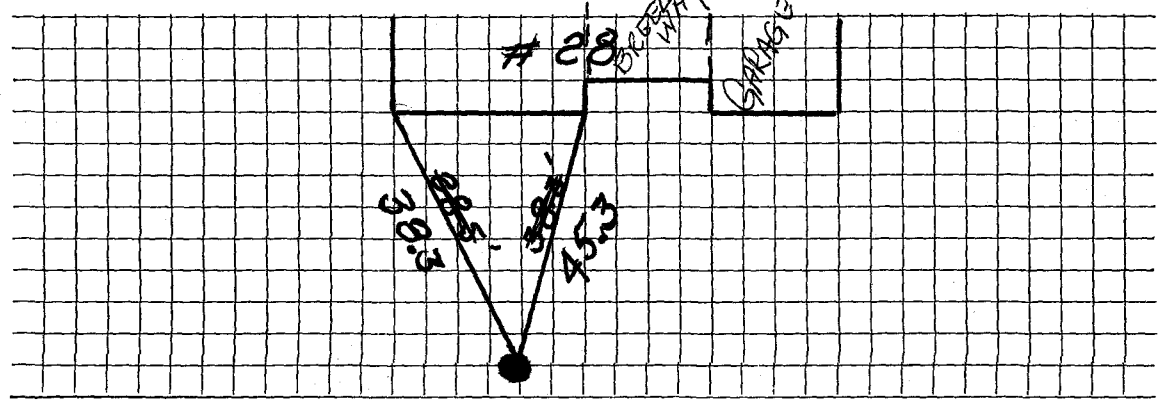

Connection made in _____ Street.

Work completed _____ 19

Remarks: