

## WATER SERVICE RECORD

# 4384

Name Brookside Bldg. Trust

Service No. 240

Address 31 Middleby Rd.

# 7753

Location Lexington

~~Repair Service~~ New Service

Com. 9-14-53


Date	Material	Amount	Total	Date	Amount
8/19/53	Labor	12 50		8-11-53	Deposited 50 00
	10% overhead	1 25	13 75	9-14-53	Refunded 1 26
	42'-3/4" Copper Tubing @.3629	15 24			NON CHARGE 48 74
	1-3/4" C x 1/2 I.W.H. STOP & WASTE	4 00		8/19/53	Labor 25 00
	2 Hr. Littlefield Shovel @7.50	15 00			18'-3/4" Copper Tubing @.3629 6 53
	1 Hr. Trucking		75		1-3/4" C. Corp-cock 4 33
			48 74		1-3/4" C x 3/4" C. Curb-cock 4 67
					1-Box & Rod 3 90
					1-1/2 straight tail piece 50
					1-1/2 offset tail piece 50
					1 Hr. Littlefield Shovel 7 50
					1 Hr. Trucking 75
					53 68

DATE \_\_\_\_\_

TOWN OF LEXINGTON — BOARD OF PUBLIC WORKS

WATER DIVISION

Sketch of Service Here

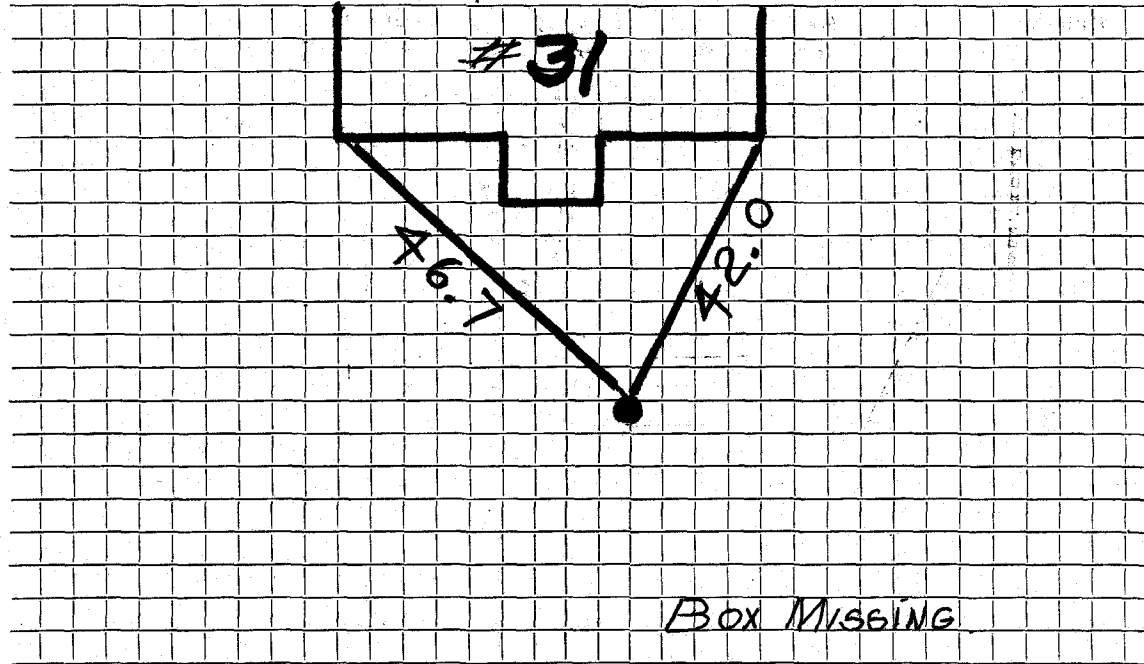

Connection made in ..... Street. Work completed .....

Remarks: .....

.....

.....