

Name K. V. Wolsey

Service No.

63 # 2478
#6516

Address 34 Middleby Road
Lexington, Mass.

Location 34 Middleby Road

Kind of Pipe

Size

Size of Main

~~Repair~~ ~~Renewal~~ New Service

Com. 8-23-48

Location

Date	Material	Amount	Total	Date	Amount
June 10, '48	Labor	1 15	1 15	June 7 '48	Deposited 30 00
	10% Overhead		12	Aug 20' 48	Refunded 27 28
	2 - 3/4" x 1/2" Bushings @ .35		70		Non-Charge 2 72
	Trucking 1 hr. @ .75		75	June 10, '48	Labor 5 15
			2 72	26' - 3/4" Copper Tubing @ .255	6 63
	Pipe supplied and laid by owner			1 - 3/4" C Corp-cock	3 00
				1 - 3/4" C x 3/4" C Curb-cock	3 68
				1 - Box & Rod	3 55
				2 - 1/2" Straight Tail Pieces	60
				Trucking 1 hr. @ .75	75
				Littlefield shovel 4 hrs. @ 7.00	28 00
					51 36
	Labor			Teardown	
				New House Hasn't	
				Been Built Yet	
				10-29-99	
				JMDR	

Hidley Press, Inc., Lexington

DATE _____

TOWN OF LEXINGTON—BOARD OF PUBLIC WORKS

WATER DIVISION

The undersigned applies for a supply of water at No. _____ St. and hereby agrees to comply with the rules and regulations as now, or at any future time, established by the Board of Selectmen.

Am't. of Estimate \$ _____


Owner _____

Am't. Paid \$ _____

Address _____

Builder _____ *137 Sun St. Malden Mass*

Sketch of Service Here

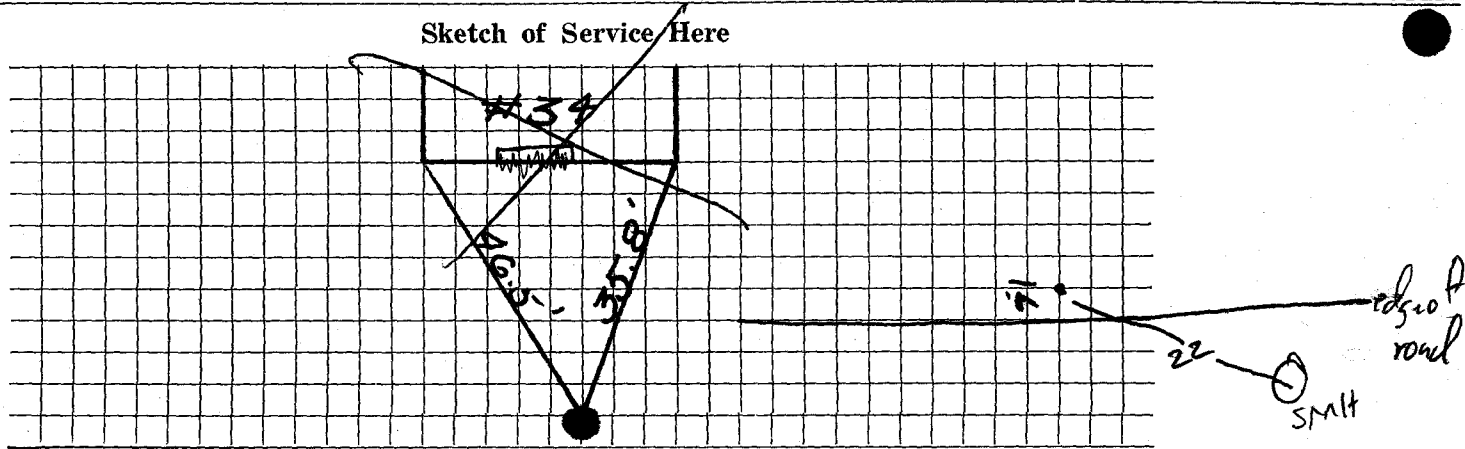

Connection made in _____ Street.

Work completed _____ 19

Remarks:

7 feet from edge of road