

WATER SERVICE RECORD

Name Robert Ericson

Service No. 18

Address 39 Middleby Road

Location

~~Repair~~ Renewal — New Service


Comm. 4/29/57

Date	Material	Amount	Total	Date	CURB TO MAIN	Amount
3/9/57	labor	30 40			labor	8 10
	10% overhead	3 04	33 44	10'	3/4" copper tubing @ .4228	4 23
	38' 3/4" copper tubing @ .4228		16 07	1	3/4" C corp cock	4 64
	1 3/4" C x 1/2" IWH Stop & Waste		4 96	1	3/4" C curb cock	5 94
	1 hr trucking @ .75		75	1	bx & rod	4 62
	2 1/3 hrs. town shovel @ 6.50		15 16	1	1/2" straight tail pc.	50
			70 38	1	1/2" offset " "	50
				2/3	hr. town shovel @ 6.50	4 32
						32 85
				3-8-57	Deposit	\$ 100 00
				4-29-57	Refund	29 62
						\$ 70 38

DATE _____

TOWN OF LEXINGTON — BOARD OF PUBLIC WORKS

WATER DIVISION

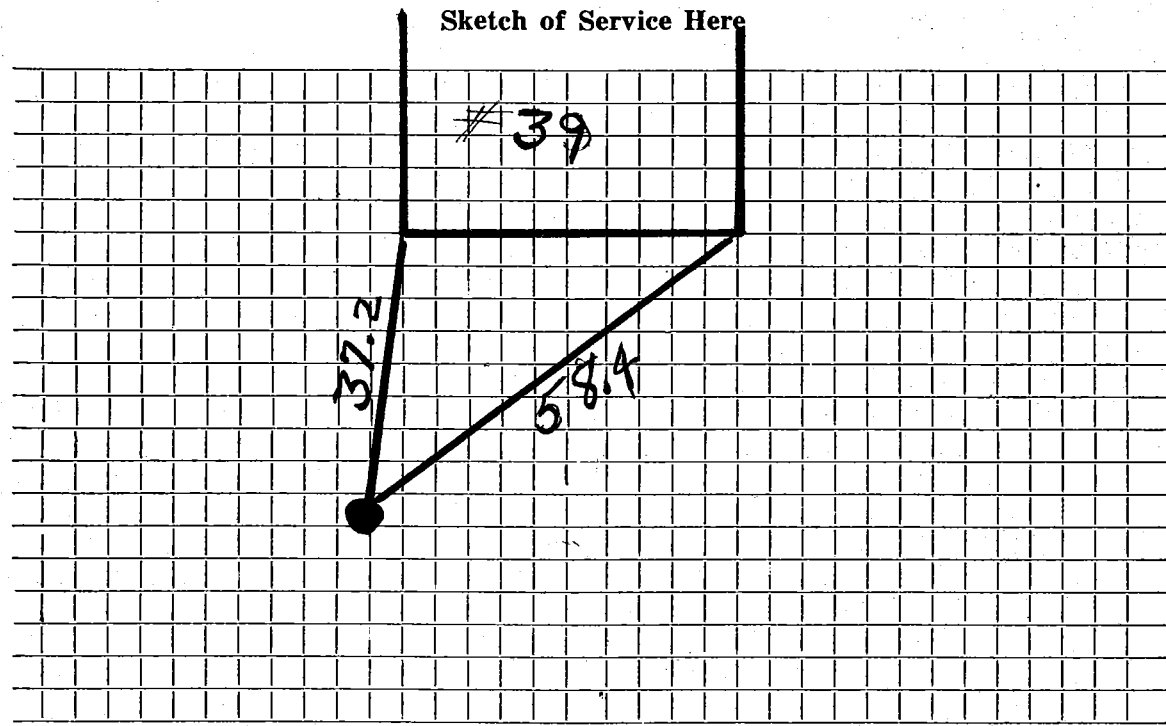

Connection made in Street. Work completed

Remarks:
.....
.....