


DATE _____

TOWN OF LEXINGTON — BOARD OF PUBLIC WORKS

WATER DIVISION

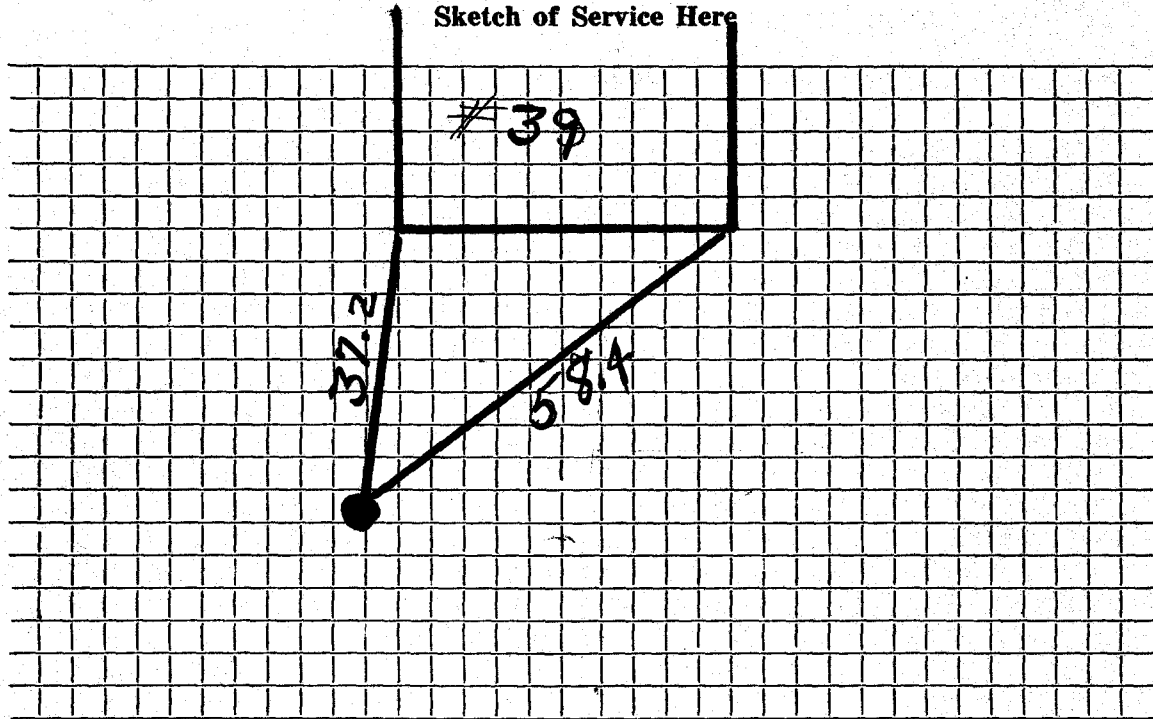

Connection made in Street. Work completed

Remarks:

.....

.....

Name Newton Crandall

Service No.

#5448
#8827

Address 40 Middleby Road

Lexington, Mass.

Location 40 Middleby Road

Kind of Pipe

Size

Size of Main

~~Renewal~~ New Service

Com. 8-23-48

Location

Date	Material	Amount	Total	Date	Amount
Jul. 6, '48	Labor	3 25	3 25	June 26 '48	40 00
	10% Overhead		33	July 20 '48	8 32
	40' - 3/4" Copper Tubing @.255	10 20			31 68
	1 - 3/4" C x 1/2" I.W.H. S & W	3 15		Jul. 6, '48	Labor
	Littlefield Shovel 2 hrs. @ 7.00	14 00			3 25
	Trucking 1 hr. @.75	75		22' - 3/4" Copper Tubing @.255	5 61
			31 68	1 - 3/4" C Corp-cock	3 00
				1 - 3/4" C x 3/4" C curb-cock	3 68
				1 - Box & Rod	3 55
				1 - 1/2" Straight Tail Piece	30
				1 - 1/2" Offset Tail Piece	30
				Littlefield Shovel 2 hrs. @ 7.00	14 00
				Trucking 1 hr. @.75	75
	Labor				34 44

Deposited
Refunded
Non-Charge

Hadley Press, Inc., Lexington

DATE _____

TOWN OF LEXINGTON—BOARD OF PUBLIC WORKS

WATER DIVISION

The undersigned applies for a supply of water at No. _____ St. and hereby agrees to comply with the rules and regulations as now, or at any future time, established by the Board of Selectmen.

Am't. of Estimate \$ _____

Owner _____


Am't. Paid \$ _____

Address _____

Builder _____

89 Albion St. Weymouth Mass.

Sketch of Service Here

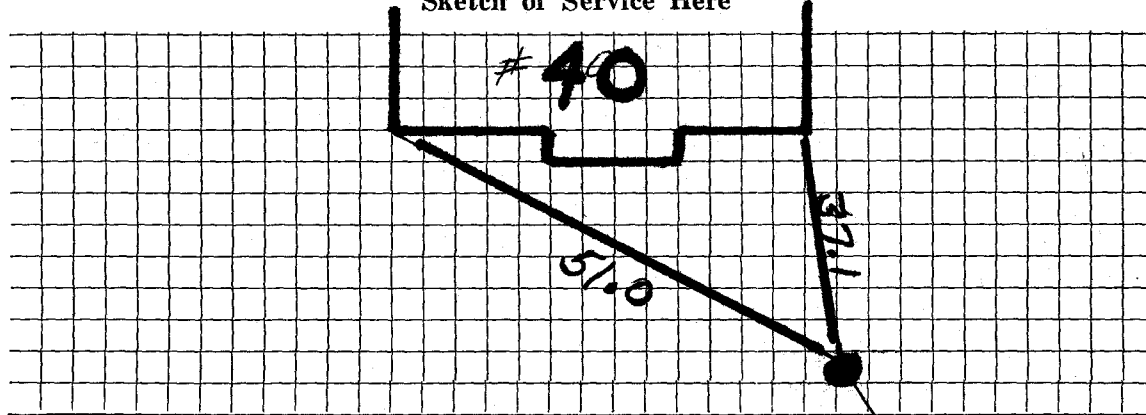

Connection made in _____ Street.

Work completed _____ 19

Remarks:

*4.10.21
HYD.*