

Name H. A. Beckett

Service No. 163

Address 10 Milk Street

#4068

Lexington, Mass.

Location 10 Milk Street

Kind of Pipe

Size

Size of Main

~~Repair~~ ~~Renewal~~ New Service

Com. 9-5-50

Location

Date

Material

Amount

Total

Date

Amount

Jul. 22, '50

Labor

4 23

4 23

July 11 '50 Deposited

45 00

10% Overhead

42

23' - 3/4" Copper Tubing @.23

5 29

No Charge

27 98

1 - 3/4"C x 1/2" I.W.H. S&W

3 29

Jul, 22, '50

Labor

4 23

Littlefield Shovel 2 hrs. @ 7.00

14 00

30' - 3/4" Copper Tubing @.23

6 90

Trucking 1 hr. @.75

75

1 - 3/4"C Corp-cock

3 15

27 98

1 - 3/4"C x 3/4"C Curb-cock

3 85

1 - Box & Rod

3 35

1 - 1/2" Straight Tail Piece

38

1 - 1/2" Offset Tail Piece

38

Littlefield Shovel 2 hrs. @ 7.00

14 00

Trucking 1 hr. @.75

75

Labor

36 99

Hadley Press, Inc., Lexington

DATE _____

TOWN OF LEXINGTON—BOARD OF PUBLIC WORKS

WATER DIVISION

The undersigned applies for a supply of water at No. _____ St. and hereby agrees to comply with the rules and regulations as now, or at any future time, established by the Board of Selectmen.

Am't. of Estimate \$ _____


Owner _____

Am't. Paid \$ _____

Address _____

Builder _____

Sketch of Service Here

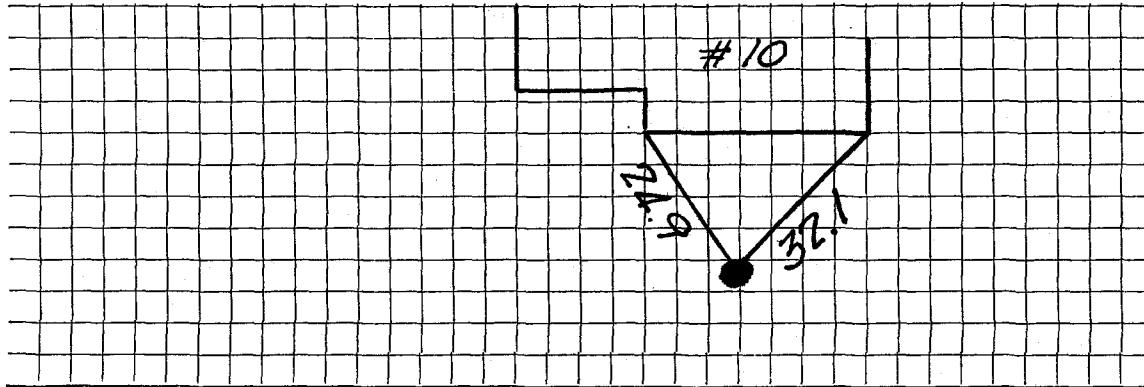

Connection made in _____ Street.

Work completed _____ 19

Remarks: