

WATER SERVICE RECORD

Name Elta M. Beckett

Service No. 104 2762

Address 12 Milk Street

Location Lexington, Mass.

~~Repair~~ ~~Renewal~~ New Service

Com. 8-6-51


Date	Material	Amount	Total	Date	Amount
6-5-51	Labor	2 98	2 98	May 23 '51	25 00
	10% Overhead		30		10 11
	30' - 3/4" Copper Tubing @.326	9 78	9 78		14 11
	1 - 3/4"C x 1/2" I.W.H. S&W	4 00	4 00	6-5-51	7 12
	Littlefield Shovel 1 hr. @ 7.00	7 00	7 00	60' - 3/4" Copper Tubing @.326	19 56
	Trucking 1 hr. @ .75	75	75	1 - 3/4" Corp-cock	4 33
			24 81	1 - 3/4" C x 3/4" Curb-cock	4 67
				1 - Box & Rod	4 68
				1 - 1/8" Straight Tail Piece	50
				1 - 1/8" Offset Tail Piece	50
				Littlefield Shovel 3 hr. @ 7.00	21 00
				Trucking 1 hr. @ .75	75
					63 11

DATE _____

TOWN OF LEXINGTON — BOARD OF PUBLIC WORKS

WATER DIVISION

Sketch of Service Here

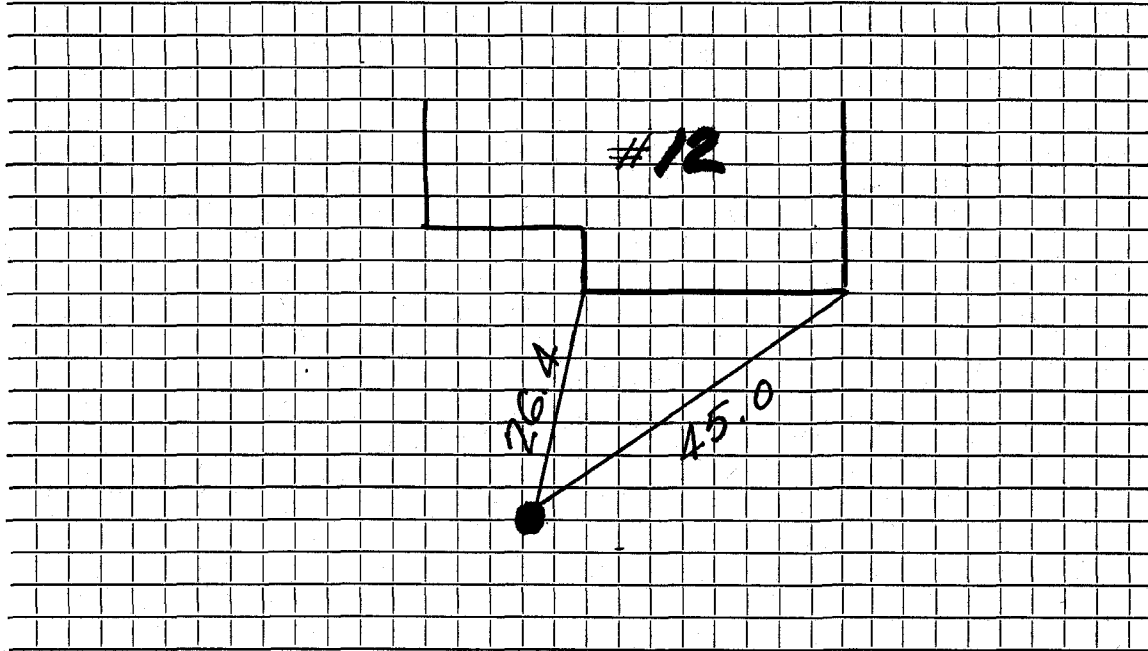

Connection made in Street. Work completed

Remarks:

.....
.....