

Name George Selfridge

Service No. 12

Address 13 Milk Street

3392

Lexington, Mass.

Location 13 Milk Street

Kind of Pipe

Size

Size of Main

~~REPAIR TO EXISTING~~ New Service Com. 2-21-49

Location

Date	Material	Amount	Total	Date	Amount
Jan 15, '49	Labor	16 87	16 87	Jan 14, '49	50 00
	10% Overhead		1 69	Sub 24 '49	3 05
	55' - 3/4" Copper Tubing @.27		14 85		46 95
	1 - 3/4" C x 1/2" I.W.H. S&W		3 15	Jan. 15, '49	16 86
	2 - 3/4" C x 3/4" C Unions (3 pts.) @1.32		2 64	10' - 3/4" Copper Tubing @.27	2 70
	Littlefield Shovel 1 hr. @7.00	7 00	7 00	1 - 3/4" C Corp-cock	3 00
	Trucking 1 hr.		75	1 - 3/4" C x 3/4" C Curb-cock	3 68
			46 95	1 - Box & Rod	3 55
				1 - 1/2" Offset Tail Piece	30
				1 - 1/2" Straight Tail Piece	30
				Trucking - 1 hr.	75
					31 14
	Labor				

DATE _____

TOWN OF LEXINGTON - BOARD OF PUBLIC WORKS

WATER DIVISION

The undersigned applies for a supply of water at No..... St. and hereby agrees to comply with the rules and regulations as now, or at any future time, established by the Board of Selectmen.

Am't of Estimate \$.....


Owner

Am't Paid \$.....

Address

Builder

Sketch of Service Here

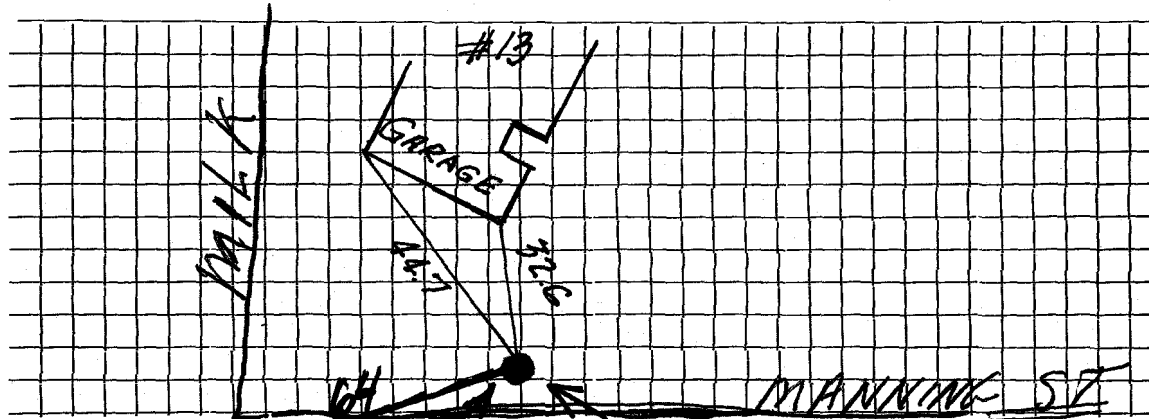

Connection made in

69

Street. 71'

Work completed

19

Remarks:

