

08682

WATER SERVICE RECORD

Name William H. Sullivan

Service No.

63

Address 14 Milk Street

Location Lexington

Repair ~~XXXXXX~~ - New Service

Com. 6-16-52


Date	Material	Amount	Total	Date	Amount
5/6/52	Labor	10 00		4-21-52 Deposited	50 00
	10% overhead	1 00	11 00	6-16-52 Paid	<u>6 86</u>
	100' - 3/4" copper tubing@.3439	34 39			56 86
	1 - 3/4" C x 1/2" I.W.H. stop & waste	4 00		NON CHARGE	
	1 - 3/4" C x 3/4" C. union	1 72		5/6/52 Labor	18 99
	1 hr. town shovel	5 00		30' - 3/4" copper tubing@.3439	10 31
	1 hr. trucking	75		1 - 3/4" C. corp-cock	4 33
			56 86	1 - 3/4" C x 3/4" C. curb-cock	4 67
				1 - box and rod	4 52
				1 - 1/2" offset tail piece	50
				1 - 1/2" straight tail piece	50
				1/2 hr. town shovel@5.00	2 50
				1 hr. trucking	75
					<u>47 07</u>

DATE _____

TOWN OF LEXINGTON — BOARD OF PUBLIC WORKS

WATER DIVISION

Sketch of Service Here

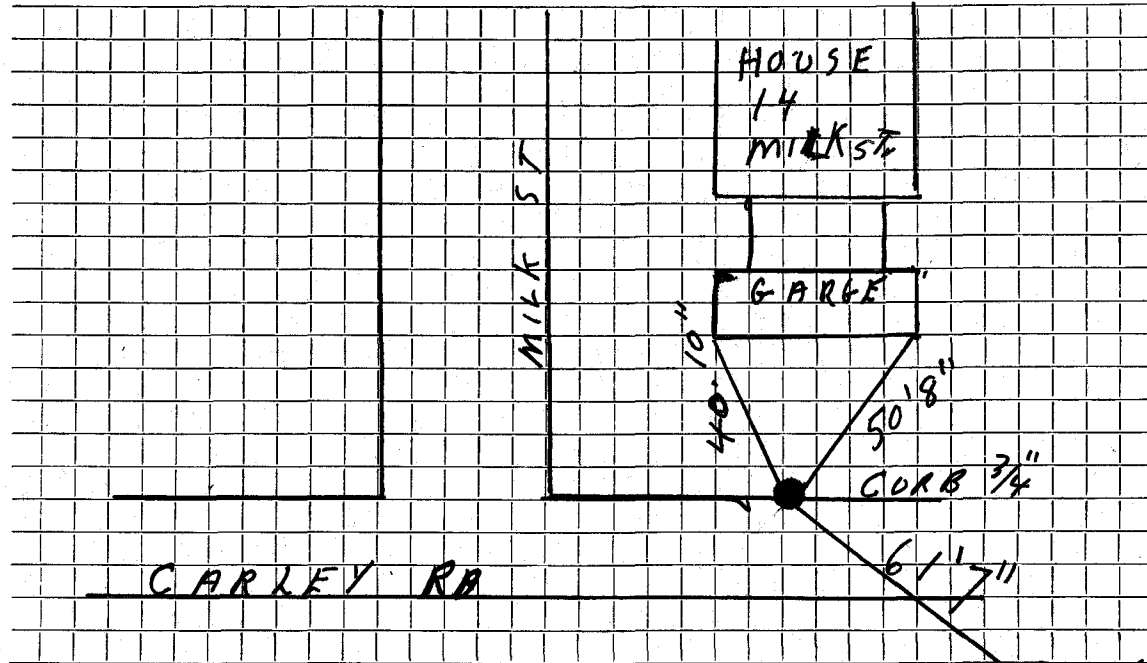

Connection made in Street. Work completed $\frac{406}{45}$

Remarks:

.....

.....