

WATER SERVICE RECORD

Name **Leland McConchie**

Service No. 206 ✓

Address **3 Milk Street**

2873

Location **Lexington, Mass.**

Repair—Renewal—New Service **COM. 10-15-51**


Date	Material	Amount	Total	Date	Amount
9-18-51	Labor	1 49	1 49	8-28-51	Deposited 25 00
	10% Overhead		15	10-15-51	Refunded 4 92
	42'-3/4" Copper Tubing. 326		13 69		No Charge 20 08
	1-3/4" Cx 1/2 I.V.H. S&W		4 00	9-18-51	Labor 4 64
	1 Hr. Trucking		75	18'-3/4" Copper Tubing	5 87
			20 08	1-3/4" C Corp-Cock	4 33
	TRENCH DUG BY OWNER			1-3/4" Cx 3/4" C Curb-Cock	4 67
				1- Box & Rod	4 68
				1-1/2 offset tail piece	50
				1-1/2 straight tail piece	50
				2 Hrs. Littlefield Shvoel	14 00
				1 Hr. Trucking	75
					39 94

DATE \_\_\_\_\_

# TOWN OF LEXINGTON — BOARD OF PUBLIC WORKS

## WATER DIVISION

Sketch of Service Here

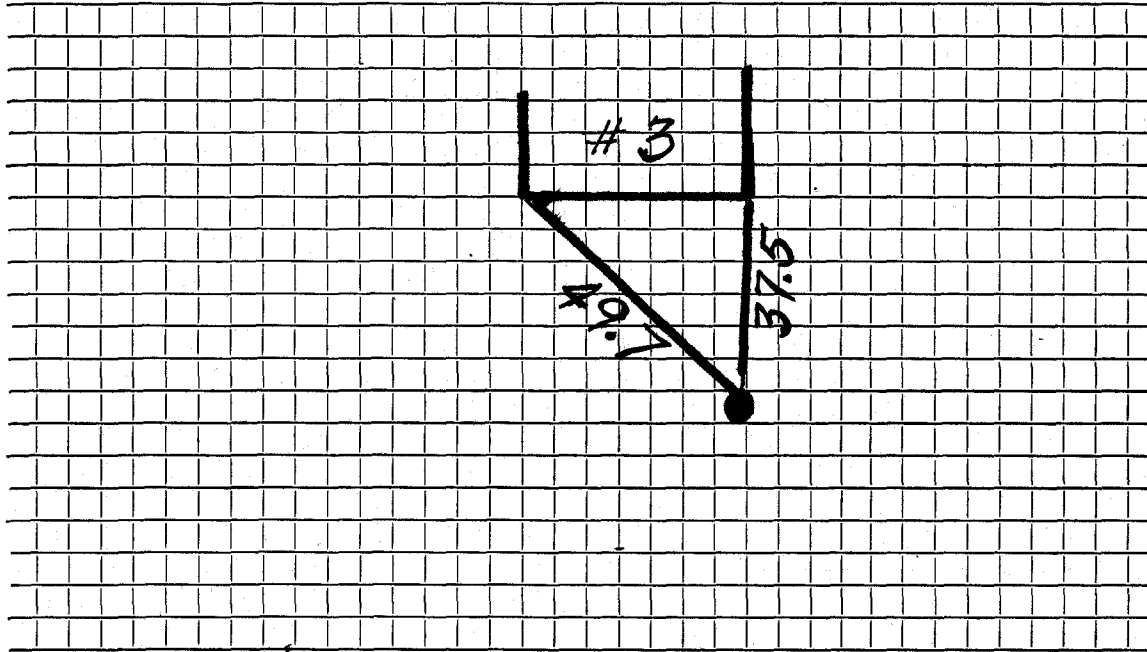

Connection made in ..... Street. Work completed .....

Remarks: .....

.....

.....