

WATER SERVICE RECORD

Name **Leland McConchie**

Service No. **206**

Address **5 Mill Street**

Location **Lexington, Mass.**

~~Repair~~ ~~Renewal~~ ~~New Service~~


COM. 10-15-51

Date	Material	Amount	Total	Date	Amount
9-18-51	Labor	1 49	1 49	8-28-51 Deposited	25 10
	10% Overhead		15	10-15-51 Refunded & credited	5 57
	40'-3/4" Copper Tubing @.326		13 04	No Charge	19 43
	1-3/4"Cx1/2 I.W.H. S&W		4 00	9-18-51 Labor	4 65
	1 Hr. Trucking		75	18'-3/4" Copper Tubing @.326	5 87
			19 43	1-3/4"C Corp-Cock	4 33
	TRENCH DUG BY OWNER			1-3/4"Cx3/4"C Curb-Cock	4 67
				1 Box & Rod	4 68
				1-1/2 offset tail piece	50
				1-1/2 straight tail piece	50
				2 Hr. Littlefield Shovel	14 00
				1 Hr. Trucking	75
					<u>39 95</u>

DATE \_\_\_\_\_

**TOWN OF LEXINGTON — BOARD OF PUBLIC WORKS**  
**WATER DIVISION**

Sketch of Service Here

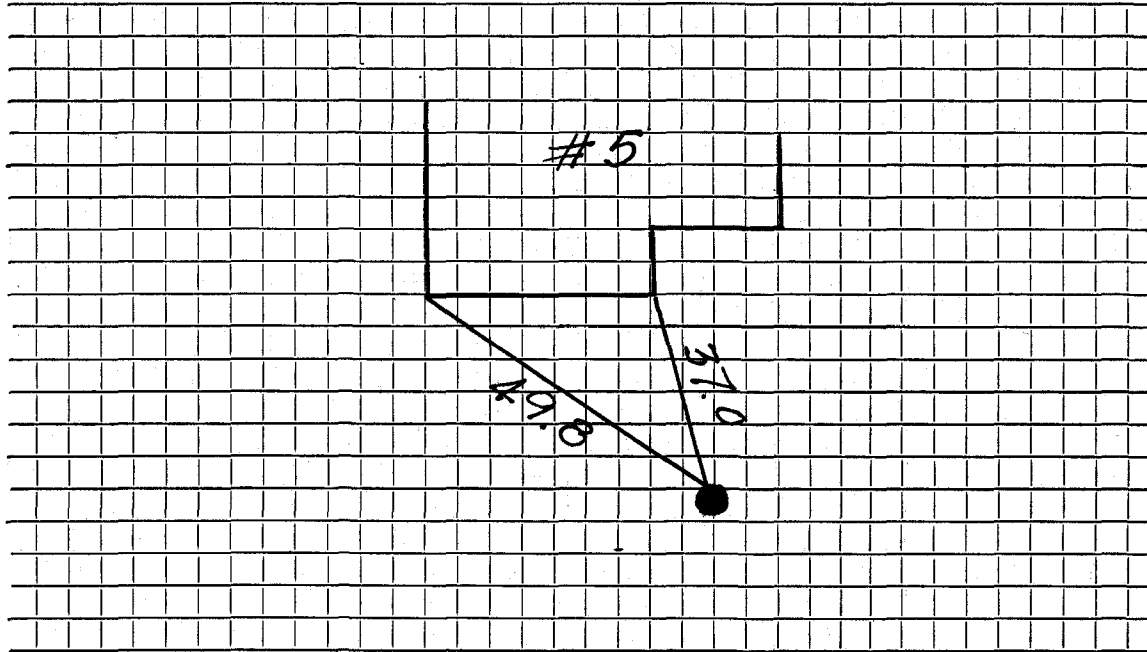

Connection made in ..... Street.      Work completed .....

Remarks: .....

.....  
.....