


DATE 10/7/2016

TOWN OF LEXINGTON — BOARD OF PUBLIC WORKS

WATER DIVISION

Sketch of Service Here

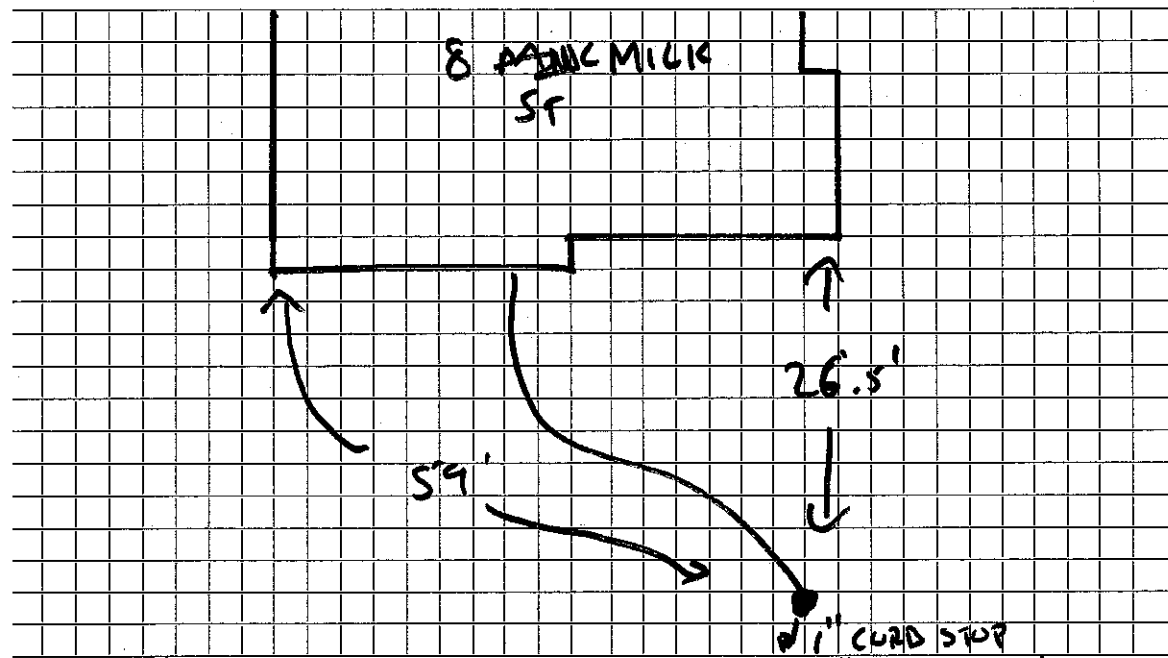

Connection made in Street. Work completed MICHAEL CLEARY

Remarks: .. DUG OUT OLD 3/4\" CURB, Left on