Service No.

			- 1	
**				
	5 .			
NI 2	me	_		
Na	1115	=		

ROAD Address 4 MILL BROOK


Location LEXINGTON, MA

Date	Material	Amount	Total	Date	 Amount
4/15/22	I" TYPE K COPPER				
	1" CURB STOP				
	Open - RIGHT				
	BUFFALO BOX				
SMyC.			·		
	34" by " COUPLING				
	7				
8. S					

Date: 4/25/22

TOWN OF LEXINGTON - BOARD OF PUBLIC WORKS WATER DIVISON

SKETCH OF SERVICE HERE

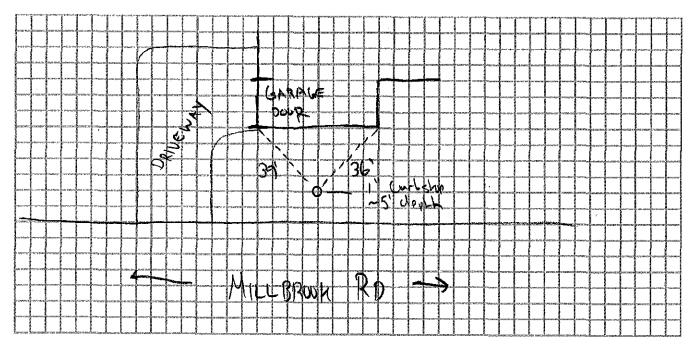

Connection made in: MILLBROW RD	Street.	Work completed:
Remarks: INSTALLED BY KI	ely Excavation	ден при
and the state of t	, , , , , , , , , , , , , , , , , , ,	ничения по подполниками и при настанденноварию общеноваю у россия каж из эконим семеноваю общеноваю в каминива
edanarossimistiksi yaarustajajaspirasedanaredaninarossi (calaba).		оолингтен (расположения при
		от на применя принципичения на простави на предоставительной принципичения на предоставительного вой Манада вод -
	por proposition to proposition of the control of the proposition of the control o	ишти поче _в аох вистиния вывиняющий дви поскавняють выкары в поменью полительной выпользовать выпоска (АОЧ выповыма -