

WATER SERVICE RECORD

Name

Service No.

Address

1 MILLBROOK

Location

Repair—Renewal—New Service

NEW SERVICE


Date		Material	Amount		Total		Date		Amount	
2/19	96	96.1' of 1" COPPER								
							8-14-53			
							10' 3/4" Copper			
							1 3/4" C. Corp Cock			
							1 3/4" C. X 3/4" C. Curb Cock			
							1 Box + Rod			

DATE 1/19/96

TOWN OF LEXINGTON — BOARD OF PUBLIC WORKS

WATER DIVISION

Sketch of Service Here

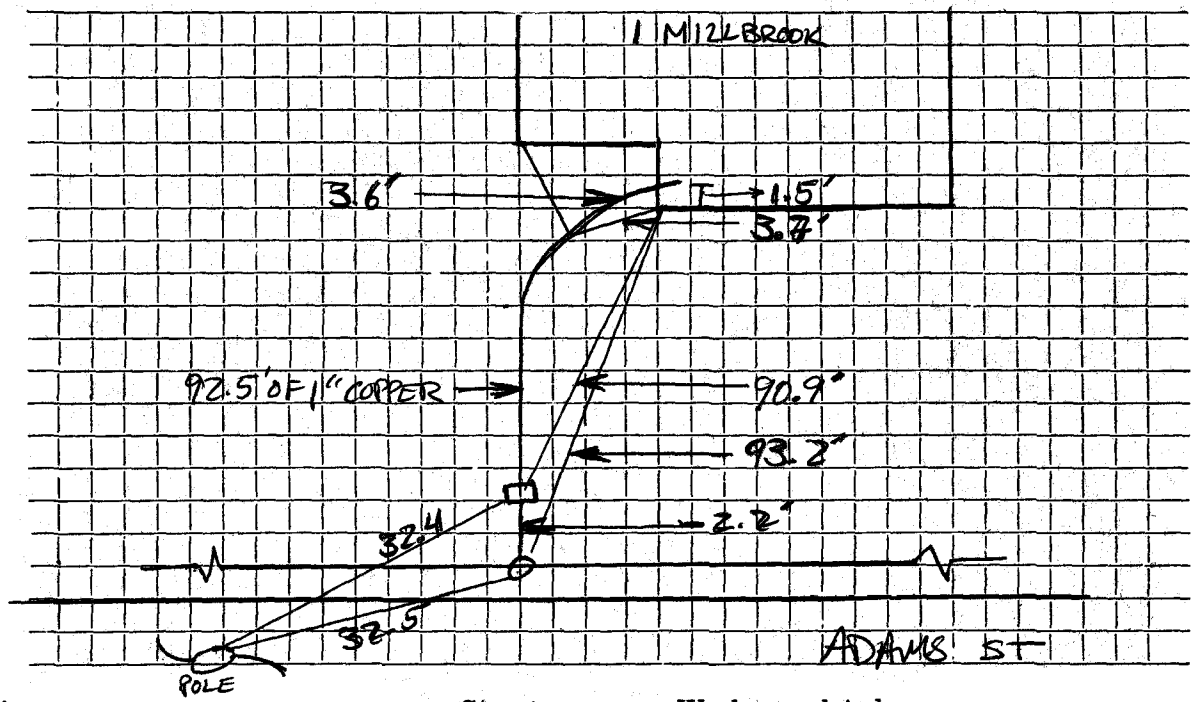

Connection made in ..... Street. Work completed .....

Remarks: .....  
.....  
.....