

WATER SERVICE RECORD

# 7024

Name

Service No.

Address 10 Millbrook Road

Location 10 MILLBROOK


~~Renewal~~ - New Service SERVICE BY BUILDER

Date	Material	Amount	Total	Date	Amount
	46' 3/4" Copper tubing				
				1-2- 58	
				29' 3/4" Copper	
				1 3/4" C. Corp Cock	
				1 3/4" C. Curb Cock	
				1 Box + Rod	

TOWN OF LEXINGTON — BOARD OF PUBLIC WORKS

WATER DIVISION

Sketch of Service Here

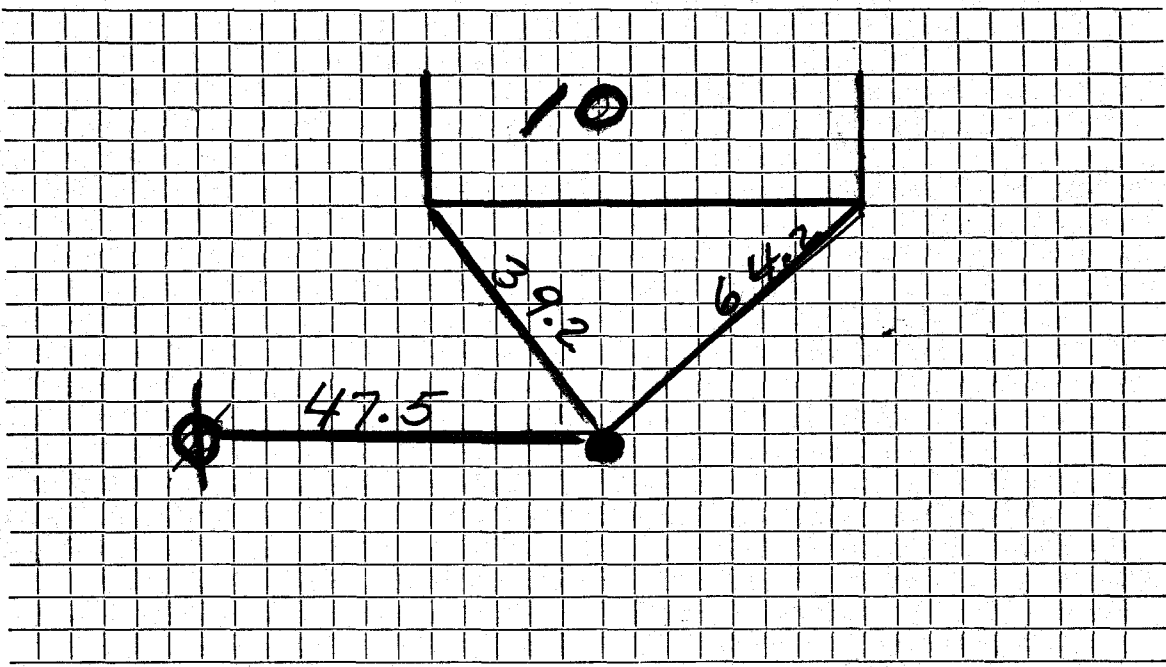

Connection made in ..... Street.      Work completed .....

Remarks: .....  
.....  
.....