

WATER SERVICE RECORD

Name

Service No. 2785

Address 2 Millbrook RD

Location

LOT 63


Repair—Renewal—New Service J. McLaw

Date		Material	Amount		Total	Date		EXIST	Amount	
5/20/08	37.6	1" Copper				7/2/54	23'	3/4 Copper		
	1	1" 3/4 Red.					1	3/4 Corp		
		buffle box					1	3/4 Curb Stop		

DATE \_\_\_\_\_

**TOWN OF LEXINGTON — BOARD OF PUBLIC WORKS**  
**WATER DIVISION**

Sketch of Service Here

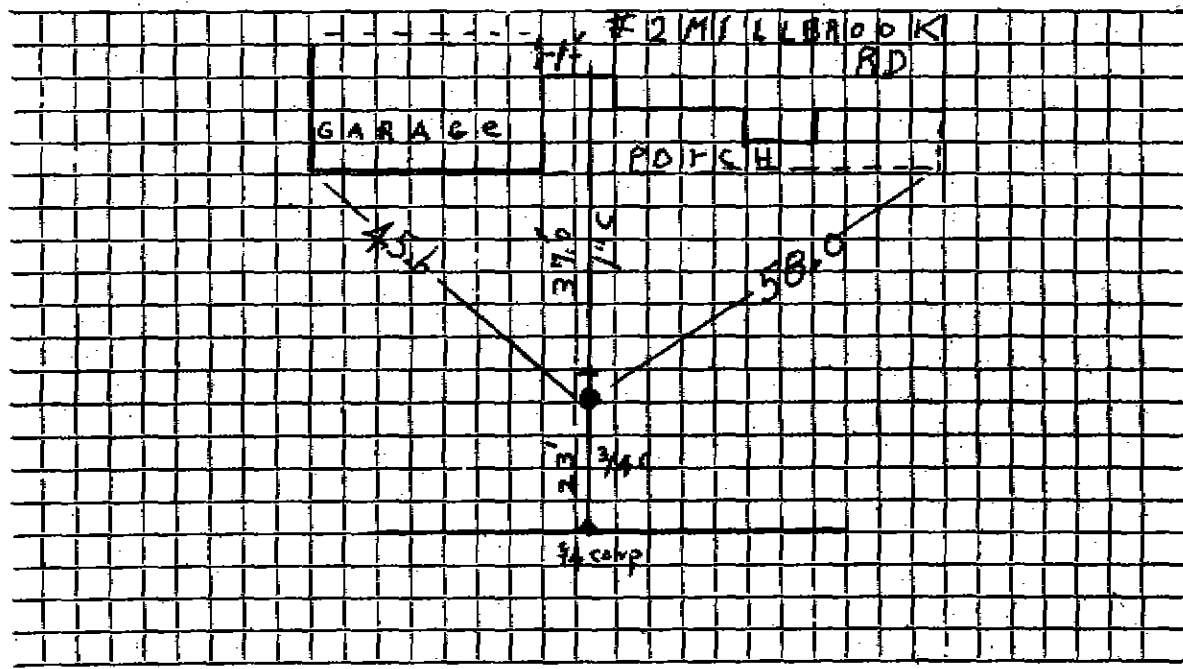

Connection made in ..... Street. Work completed .....

Remarks: .....  
.....  
.....