


TOWN OF LEXINGTON - BOARD OF PUBLIC WORKS  
WATER DIVISION

Date: 5/4/21

SKETCH OF SERVICE HERE

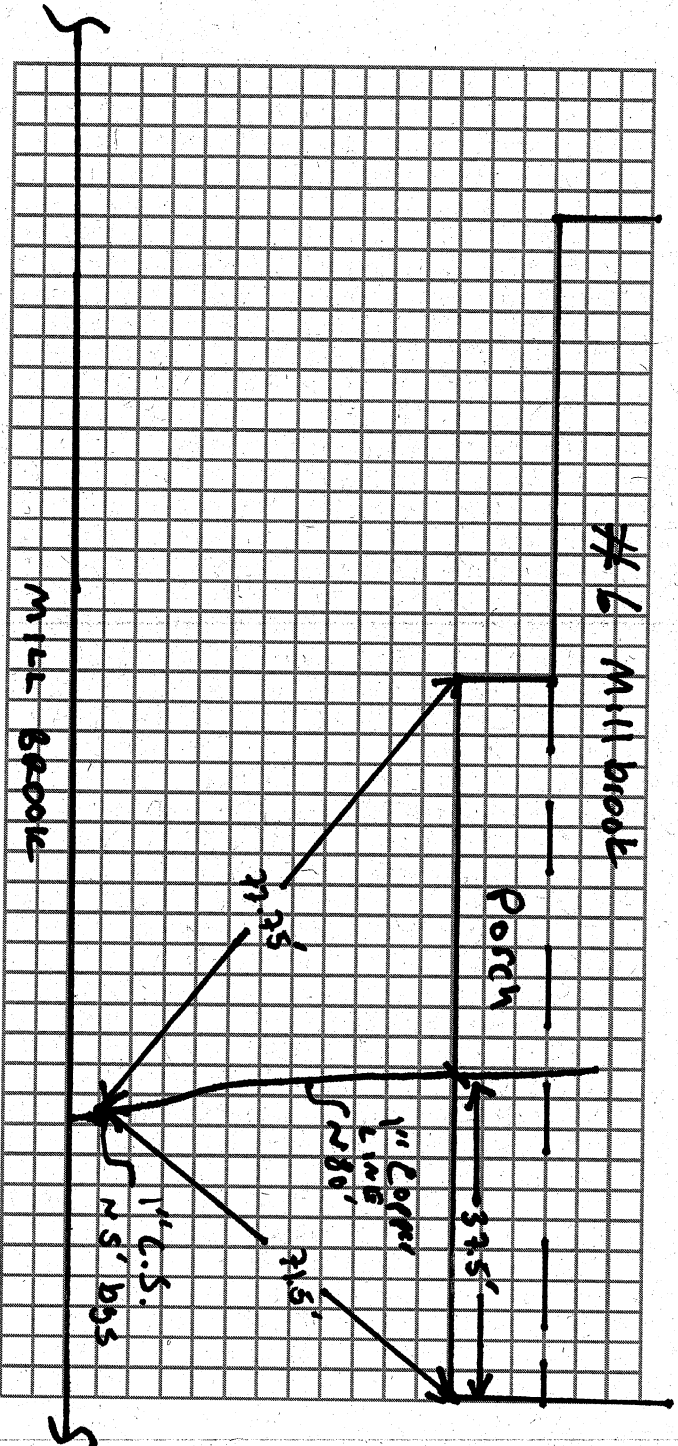

Connection made in: Mill brook

Remarks: Renewal

Street:

Work completed:

# Water Service Record

Name Lynch Development  
Address 6 Mill Brook Road  
Location  
Repair Renewal New Service

Service No. W-21-21

Date

Material

Amount

Total

Date

Amount

Total

Date

Amount

Total

5/4/21

Road → House

1" Lama Brass (1)

Open Fight C.S.

Buffalo Box (1)

Type K 1" Copper 20'

#874

WATER SERVICE RECORD

Name Emanuel Coscia, Jr.

Service No. 153

Address 6 Mill Brook Road

Location

~~Repair/Alteration~~ New Service

Comm 8-3-59

Date	Material	Amount	Total	Date		Amount
7-18-59	Labor	13.50		7-6-59	Deposit	100.00
	10% O.H.	1.35	14.85	8-3-59	Returned	20.37
	125' 3/4" Copper tubing @.3764	47.05	5.88			79.63
	1 3/4" C x 3/4" I.W.H. Stop & Waste				NON CHARGE	
	1 hr. Town Shovel @6.50	6.50		1/2/58	Labor	4 17
	2 3/4"C 3 part unions @2.30	4.60		25' 3/4" Cop. Tubing @ .37		9 25
	1 hr. Trucking @.75	.75	79.63	1 3/4" C Corp Cock		4 64
				1 3/4" C Curb Cock		6 03
				1 Box & Ros		5 00
				1 Hour Trucking @ .75		75
						29 84
					1 3/4" Straight tailpieces	.50
					1 3/4" Offset tailpiece	.50
						30.84

DATE \_\_\_\_\_

**TOWN OF LEXINGTON — BOARD OF PUBLIC WORKS**

**WATER DIVISION**

Sketch of Service Here

A large grid of graph paper, consisting of 20 columns and 20 rows, intended for sketching service details.

Connection made in ..... Street. Work completed .....

Remarks: .....  
.....  
.....