

WATER SERVICE RECORD

#873

Name John Castoldi

Service No. 44

Address 7 Millbrook Road

Location

~~XXXXXXXXXX~~ New Service


Comm 6-19-61

Date	Material	Amount	Total	Date		Amount
5-18-61	Labor	34.08		4-18-61	Deposit	100.00
	10% O.H.	3.41	37.49	6-19-61	Refund	14.37
41'	3/4" Copper Tubing @.42		17.22	5-18-61	Labor	10.80
1	3/4" c x 1/2 I.W.H. Stop & Waste		6.17	13'	3/4" Copper Tubing @.42	5.46
1	1/2 Hr. Town Shovel @6.50		9.75	1	3/4" C Corp Cock	4.91
1	Hr. Trucking @3.00		3.00	1	3/4" C Curb Cock	6.28
	12 x 3 Patch		12.00	1	Box & Rod	4.90
			85.63	1	1/2 Straight tailpiece	.50
				1	1/2 Offset tailpiece	.50
				1/2	Hr. Town Shovel @6.50	3.25
				1	Hr. Trucking @3.00	3.00
						39.60

TOWN OF LEXINGTON — BOARD OF PUBLIC WORKS

WATER DIVISION

Sketch of Service Here

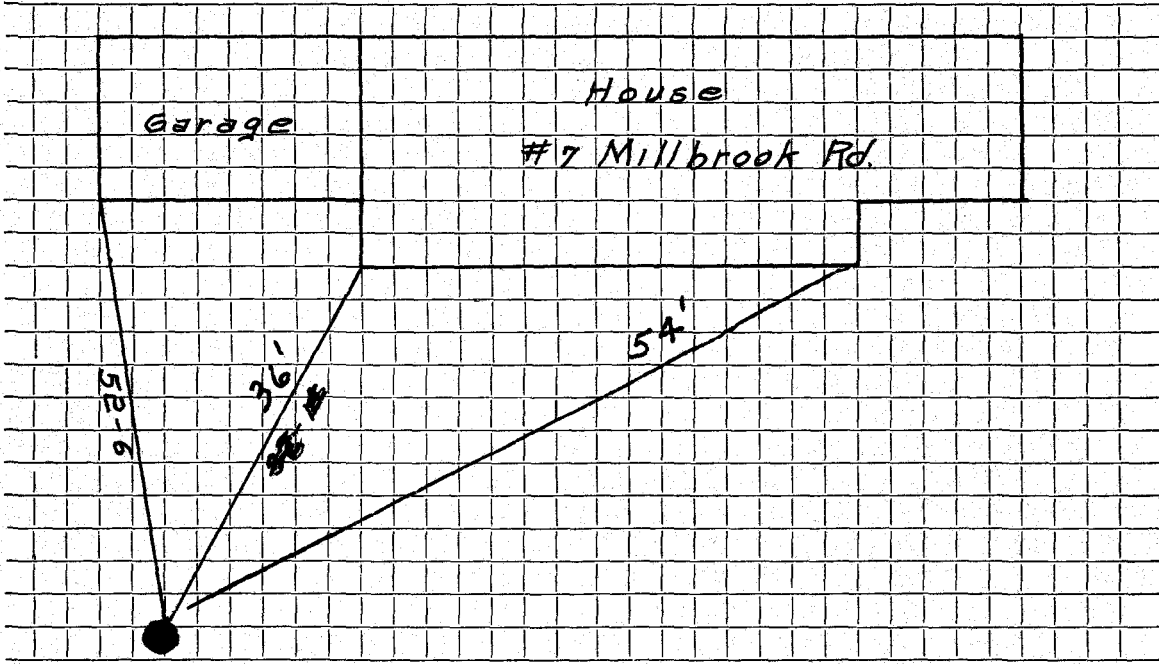

Connection made in Street. Work completed

Remarks:
.....
.....