

## WATER SERVICE RECORD

Name John W. Castoldi -

Service No. #34

Address 9 Mill Brook Road

Location

~~XXXXXX~~ New Service WO #7173

Comm 6-25-62


Date	Material	Amount	Total	Date	Amount
4-25-62	Labor	18.42		4-23-62	Deposit 100.00
	10% O.H.	1.84	20.26	6-28-62	Returned 32.72
62	3/4" Copper tubing @42		26.04		69.28
1	3/4" Cx 1/2 I.W.H. Stop & Waste		6.17		
1	3/4" C3 Part Union		2.41		Non-Charge
1	Curb Box & Rod		4.90	4/25/62	1 1/2 Straight Tailpiece 50
1	Hr. Town Shovel @6.50		6.50		1 1/2 Offset Tailpiece 50
1	Hr. Trucking @3.00		3.00		1.00
			69.28		

\* Apply 15.48 to WHC#35

TOWN OF LEXINGTON — BOARD OF PUBLIC WORKS

WATER DIVISION

Sketch of Service Here

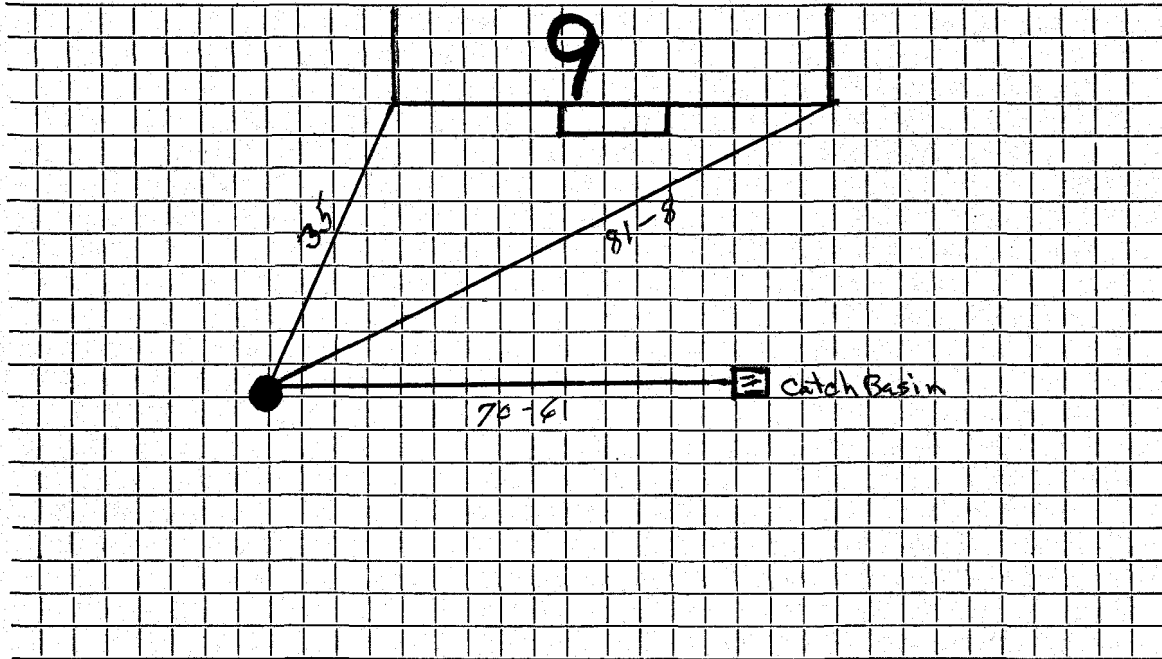

Connection made in ..... Street. Work completed .....

Remarks: .....

.....

.....