


DATE 10-23-90

TOWN OF LEXINGTON — BOARD OF PUBLIC WORKS
WATER DIVISION

Sketch of Service Here

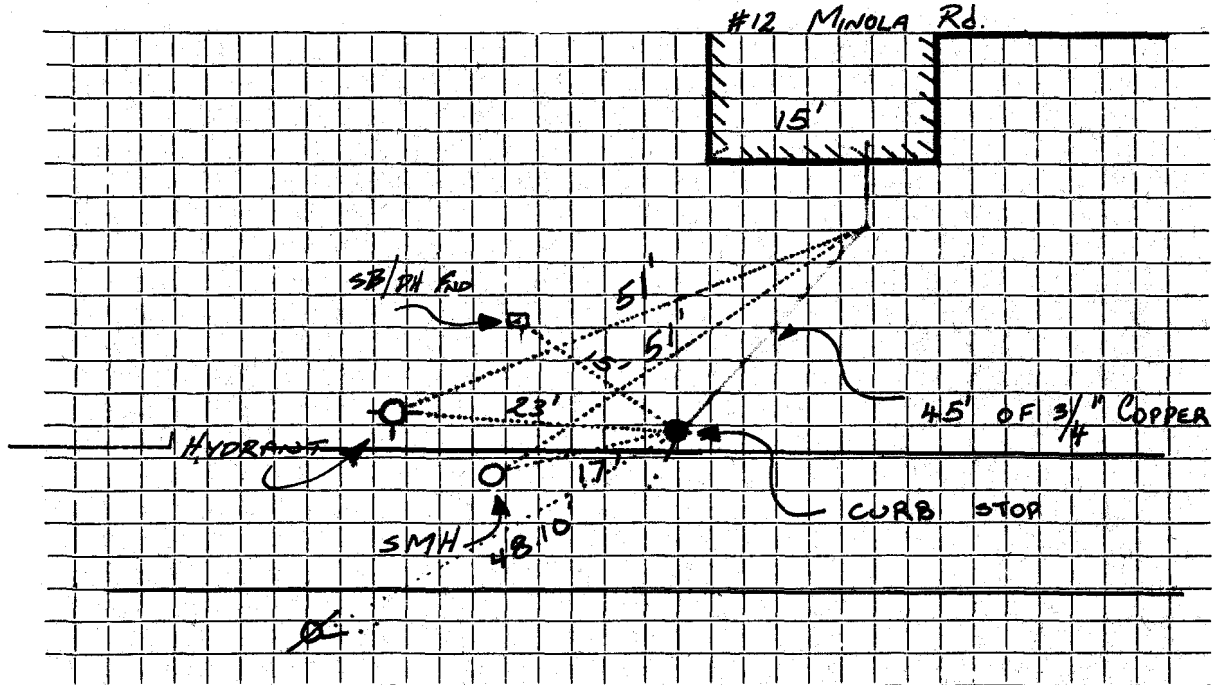

Connection made in MINOLA Rd. ~~Street~~ Work completed

Remarks: INSPECTED 10-10-90 BY P. BARROWS, CONTRACTOR: J. REDMOND