

WATER SERVICE RECORD

Name Donald Jenkins Jr.

Service No. 79

Address 8 Minola Road

1686

Location


~~Repair - General~~ New Service W.O. #8126

Comm 10-28-63

Date	Material	Amount	Total	Date	Amount
8-21-63	Labor	4 73		8-19-63	Deposit 50 00
	10% O.H.	47	5 20	10-28-63	Paid by B.H.O. #104 2 28
	80' 3/4" Copper Tubing @	42	33 60		52 28
	1 3/4" Cx 1/2 IWH Stop & Waste		6 17		
	1 3/4" C 3 part Union		2 41		NON CHARGE
	1 Box & Rod		4 90		1 1/2 Straight Tail Piece 50
			52 28		1 1/2 Offset Tail Piece 50
					1 00

TOWN OF LEXINGTON — BOARD OF PUBLIC WORKS
WATER DIVISION

Sketch of Service Here

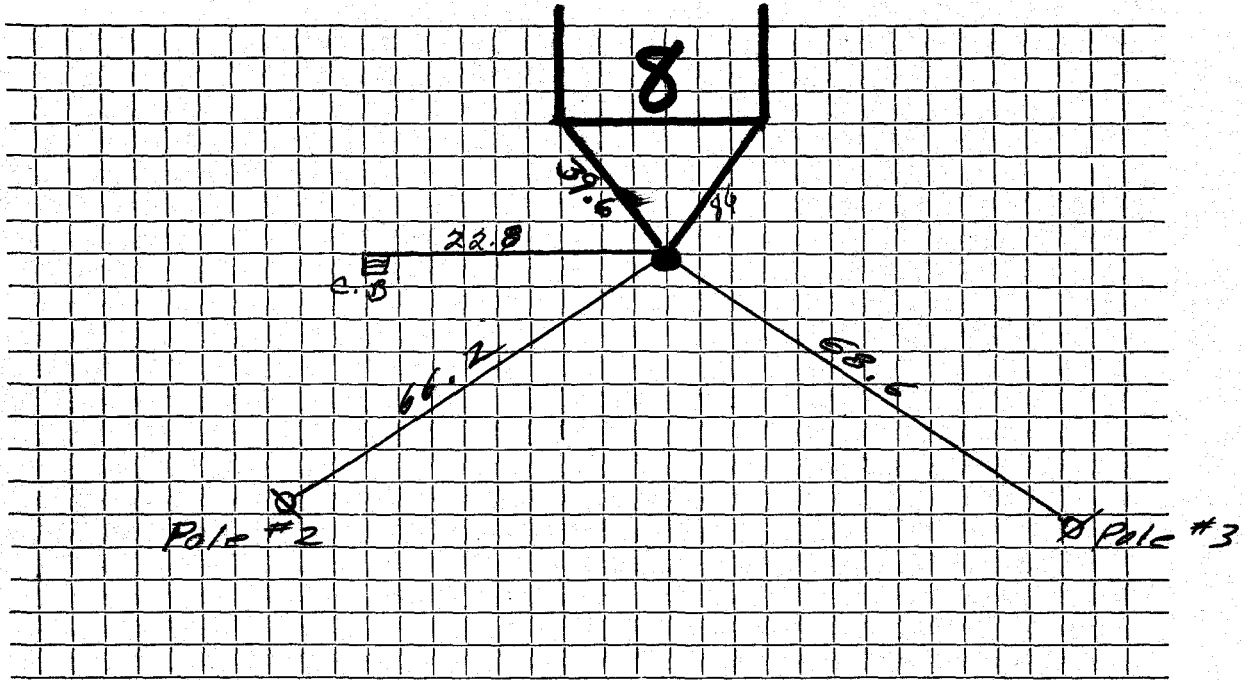

Connection made in Street. Work completed

Remarks:
.....
.....