

WATER SERVICE RECORD

Name

Service No.

Address

Location *19 MINUTE MANO LA,*

Repair—Renewal—New Service *UPGRADE mcloughlin*


Date	Material	Amount	Total	Date	Amount
<i>7/11/53</i>	<i>12' 3/4 Copper</i>				
	<i>1 3/4 CORP</i>				
	<i>1 3/4 Corb</i>				
<i>5/3/2000</i>	<i>57' 1" COPPER</i>				
	<i>3/4x1"</i>				
	<i>Bufflo box</i>				

DATE _____

TOWN OF LEXINGTON — BOARD OF PUBLIC WORKS

WATER DIVISION

Sketch of Service Here

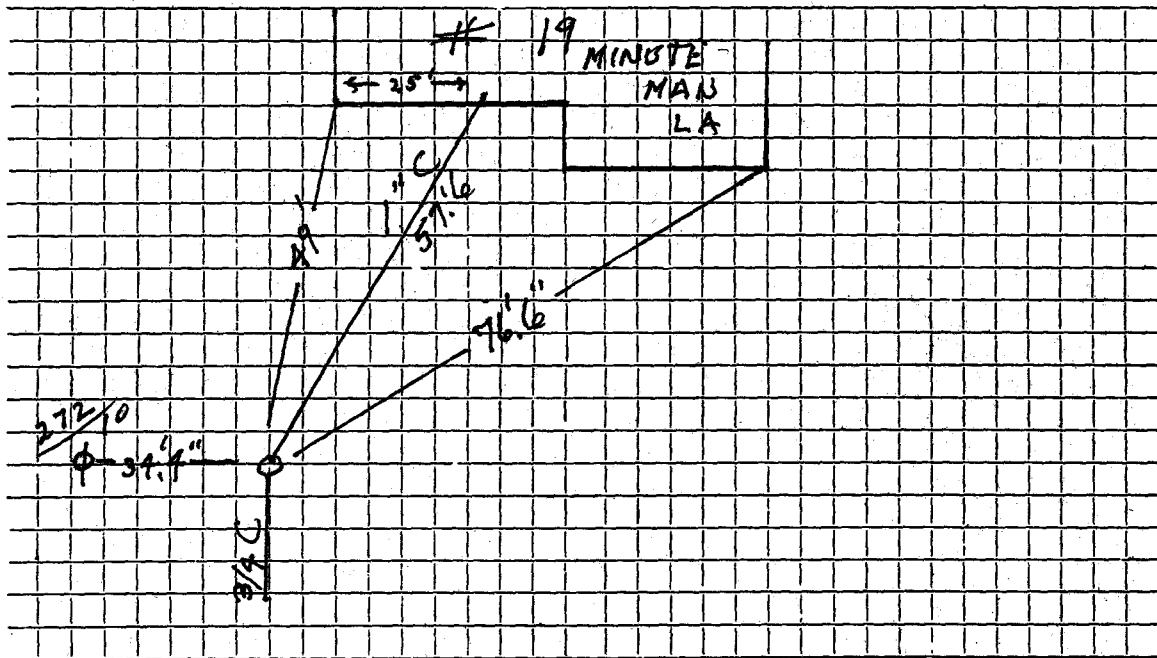

Connection made in Street. Work completed

Remarks:
.....
.....