


DATE AUGUST 28, 1997

TOWN OF LEXINGTON — BOARD OF PUBLIC WORKS

WATER DIVISION

Sketch of Service Here

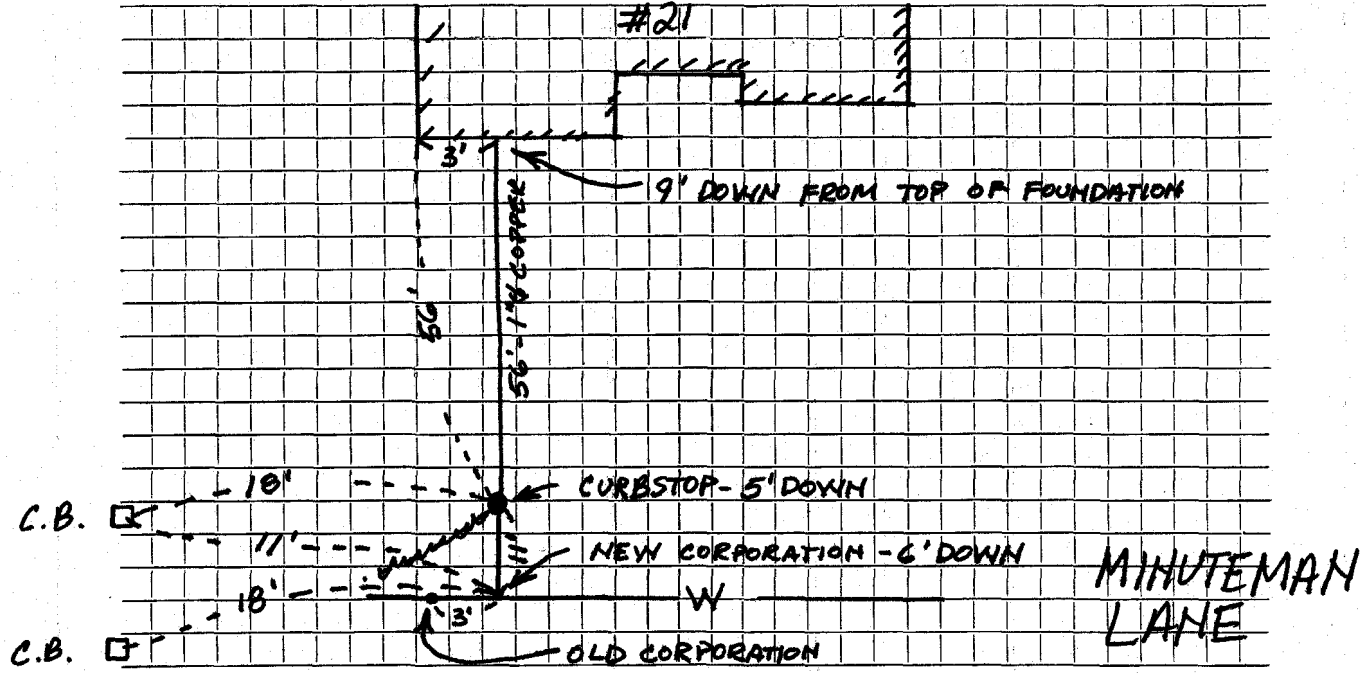

Connection made in MINUTEMAN LANE Street. Work completed

Remarks: